
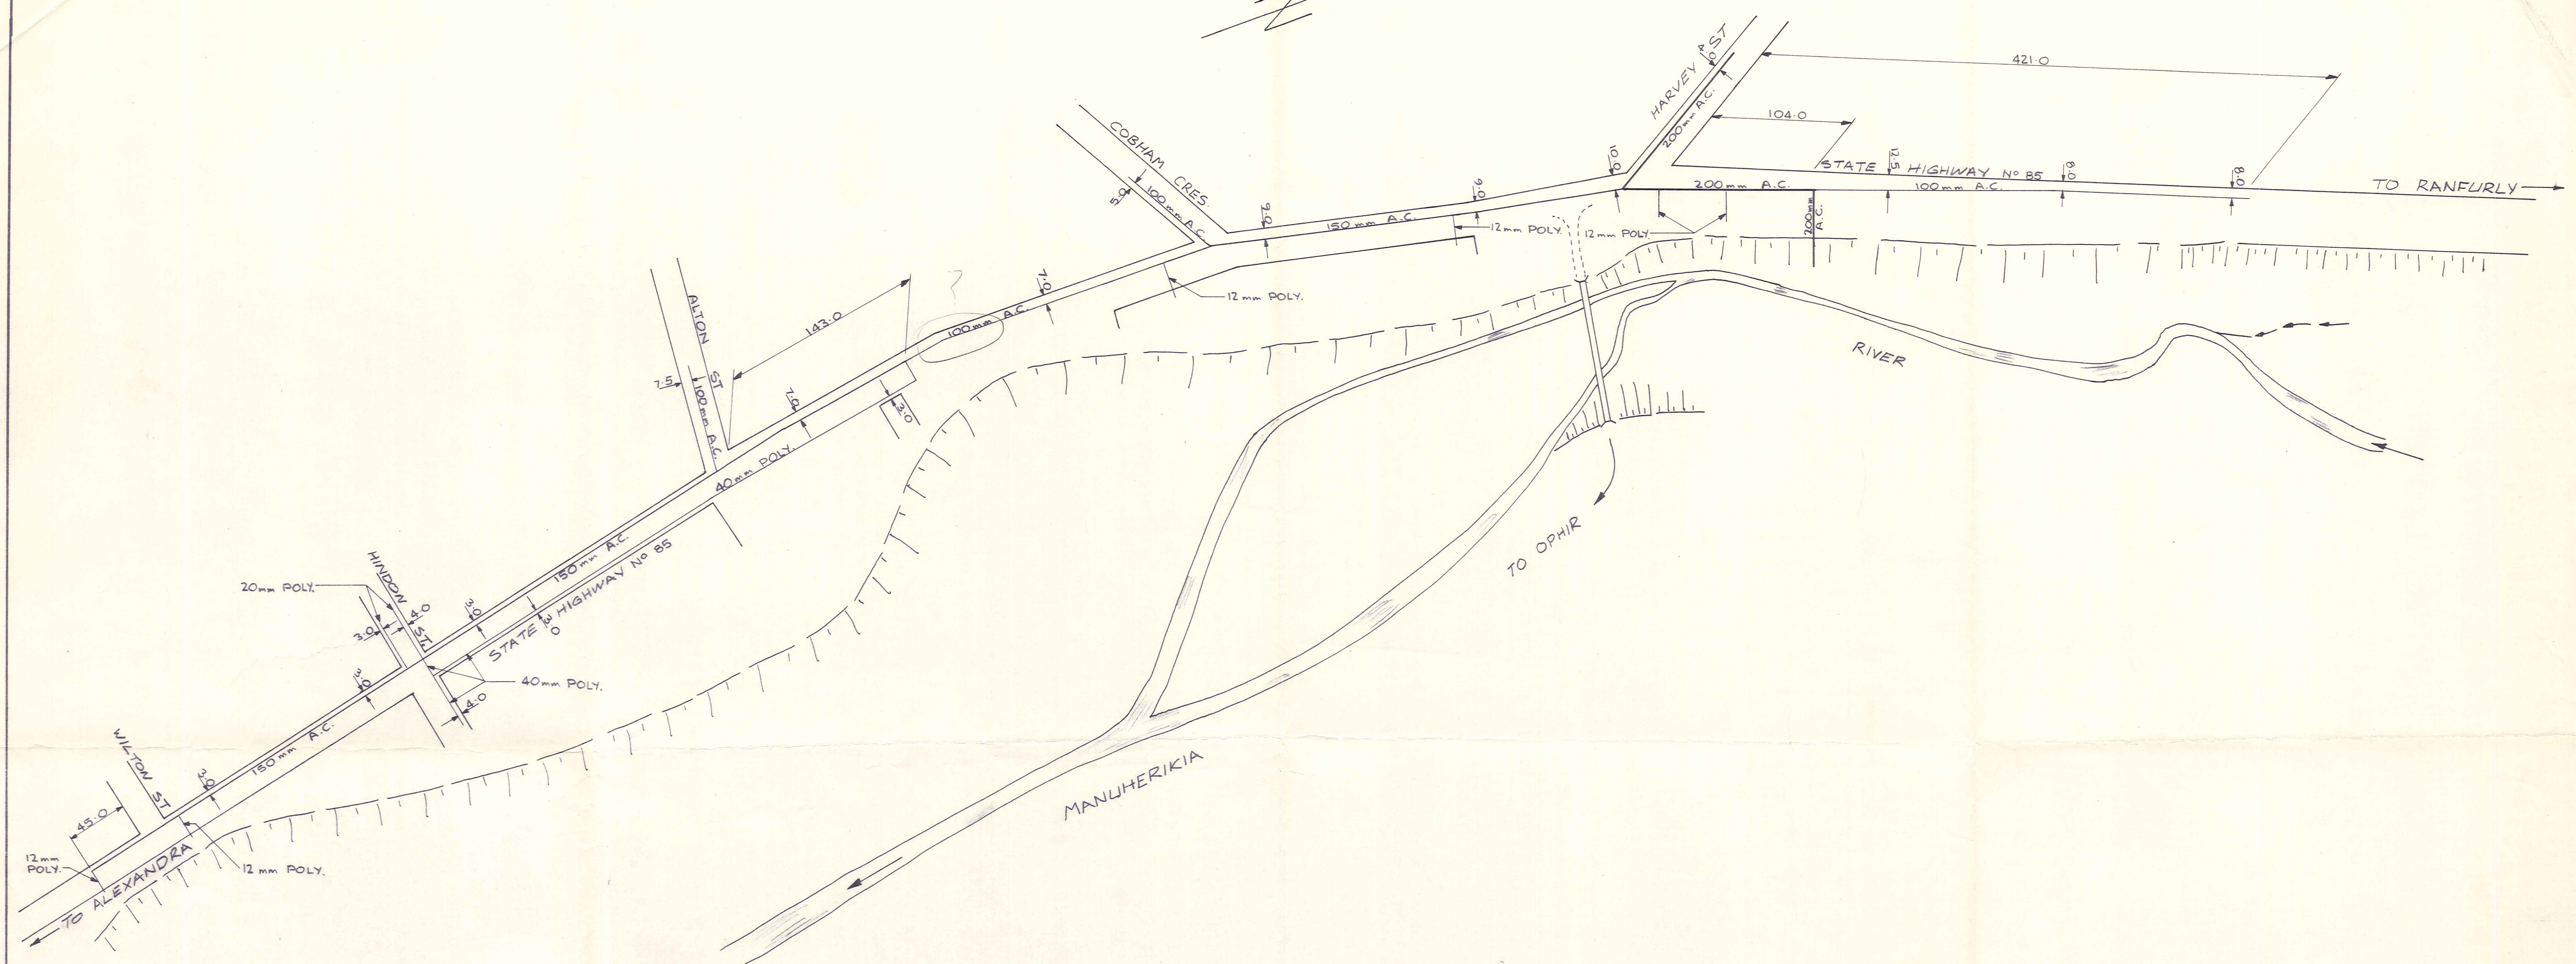


VINCENT  
 COUNTY COUNCIL

OMAKAU WATER SUPPLY  
 OPHIR SUPPLY

AMENDMENTS			NAME DATE		JOB NO.	Sheet No
NO.	BY	DATE	Appvd.		7087	1
			Surveyed	MS Blake June 81		
			Drawn	GR Duff July 81		
			Calculations	" " Aug 81		
			Traced	D. T. Mason Aug 81		
			Checked	" " "	File 156	of shts.
			Approved	" " "		

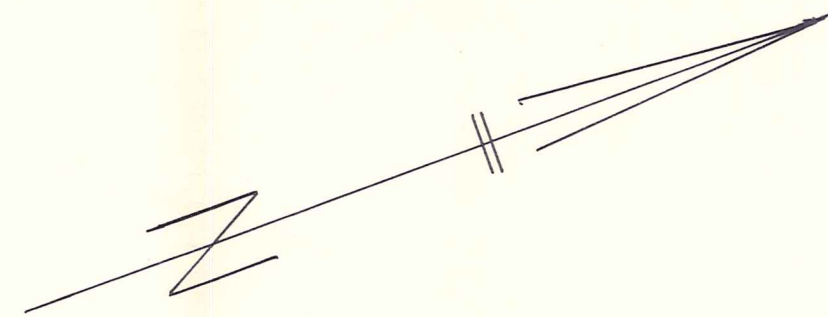

SCALE 1:2400  
(200 ft to an inch)


**DUFFILL WATTS & KING LTD.**  
CONSULTING CIVIL & STRUCTURAL ENGINEERS  
DUNEDIN, INVERCARGILL, BALCLUTHA, CROMWELL

**VINCENT COUNTY COUNCIL**

**OMAKAU WATER SUPPLY  
PIPE LINE AGREEMENT**


AMENDMENTS				NAME	DATE	JOB NO.	Sheet No
NO.	BY	DATE	Appvd.	Surveyed	G. R. DUFF	MAY '79	7087 P1
				Drawn	G. R. DUFF		of sheets
				Calculations	G. R. DUFF		
				Traced	G. R. DUFF		
				Checked	G. R. DUFF		
				Approved	<i>[Signature]</i>		

File 156 L.B. 92 F.B. -

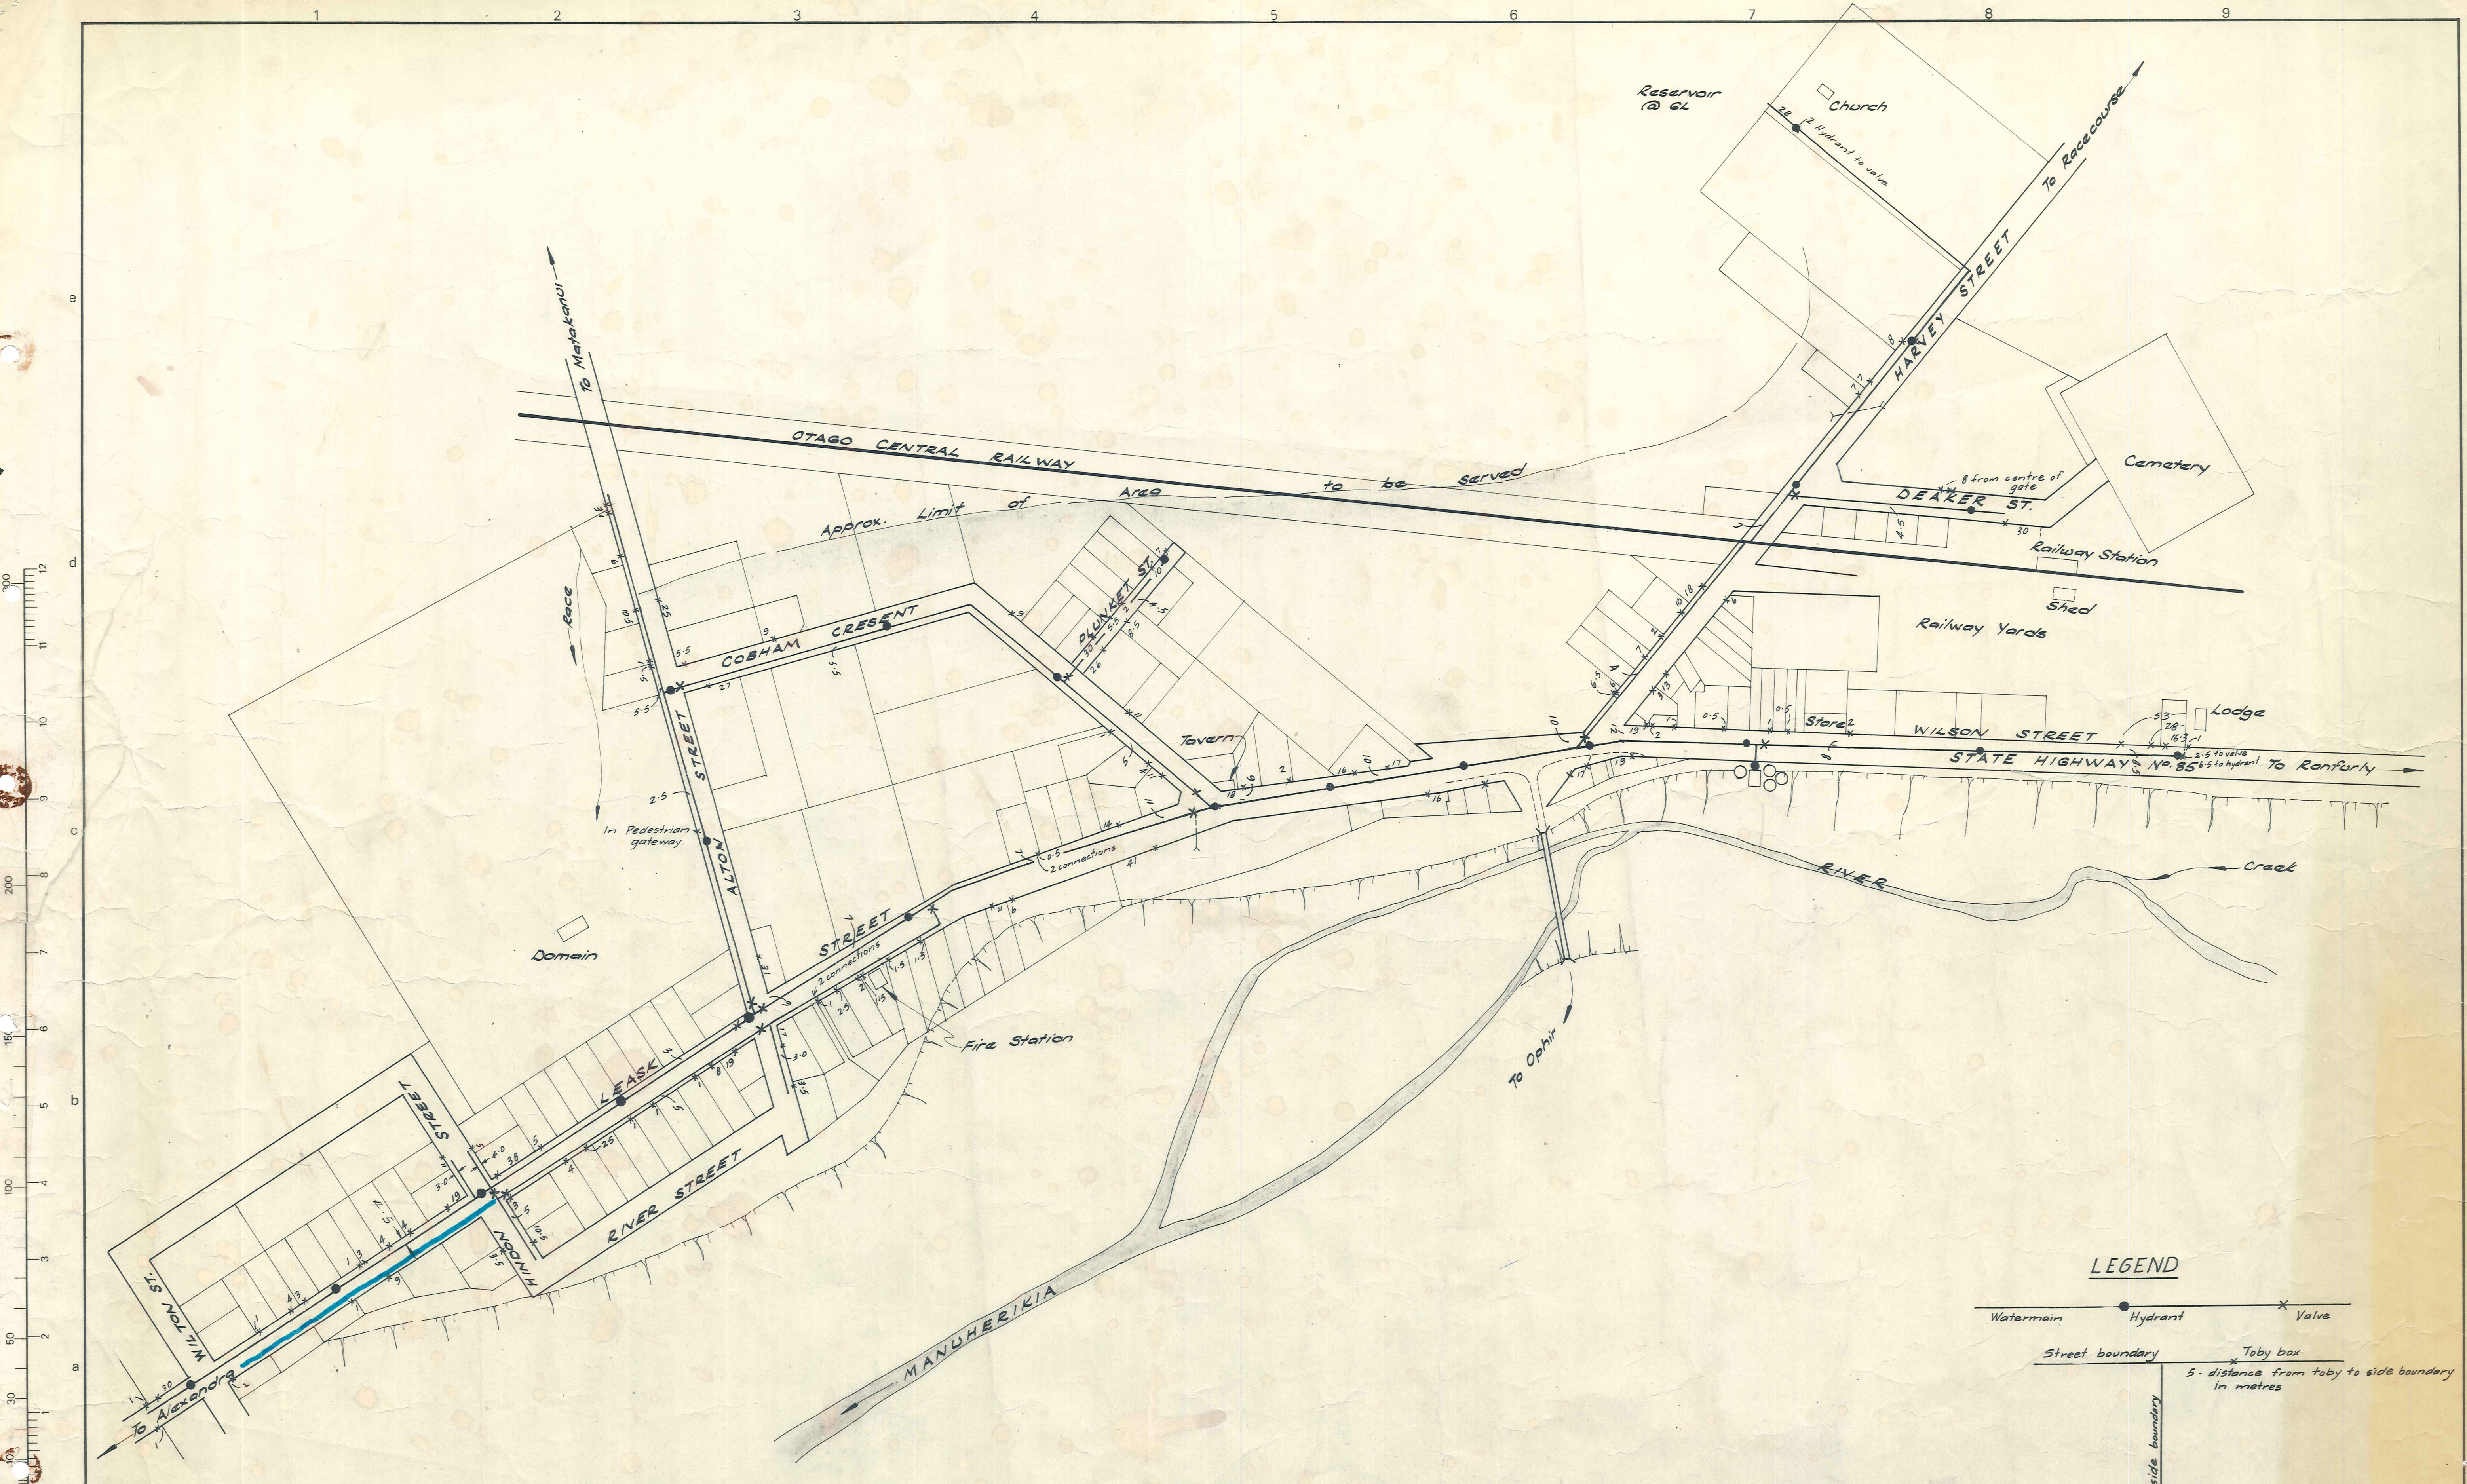

300  
200  
150  
100  
50  
0  
mm  
INCHES

**LEGEND**

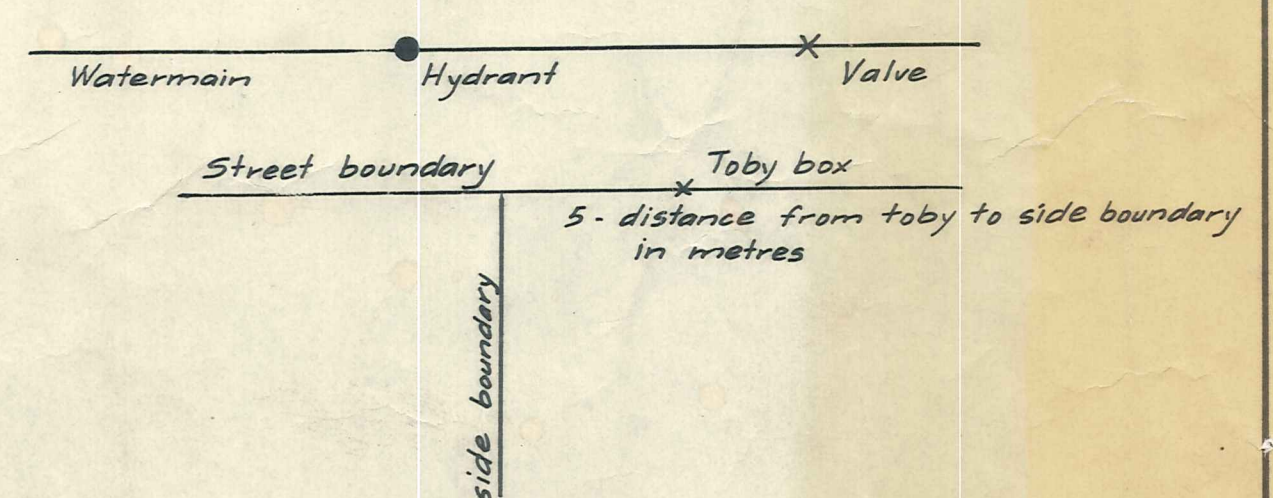

Scale; 1:2400

**PRELIMINARY DRAWING**  
NOT TO BE USED IN CONSTRUCTION

**DUFFILL WATTS & KING LTD**  
CONSULTING CIVIL & STRUCTURAL ENGINEERS  
Dunedin PO Box 5269 Ph 777-133 Invercargill PO Box 576 Ph 83-049  
Balclutha PO Box 220 Ph 81-664 Cromwell PO Box 82 Ph 50-391

**VINCENT COUNTY COUNCIL**

**OMAKAU WATER SUPPLY**  
"AS BUILT" PIPELINE LAYOUT

AMENDMENTS			NAME	DATE	JOB NO.	Sheet No
NO.	BY	DATE	Appvd.	Surveyed	9010	1
				Drawn		
				Calculations		
				Traced		
				Checked		
				Approved	File 105	L.B. 92

F.B. -