



PLAN
2 Ch to 1"

	NEW WATERMAIN
	EXISTING WATERMAIN
	FIRE HYDRANT
	THRUST BLOCK


NOTE
THIS PLAN IS TO BE READ
IN CONJUNCTION WITH - R 1014
(EXISTING SEWERS & WATERMAINS)

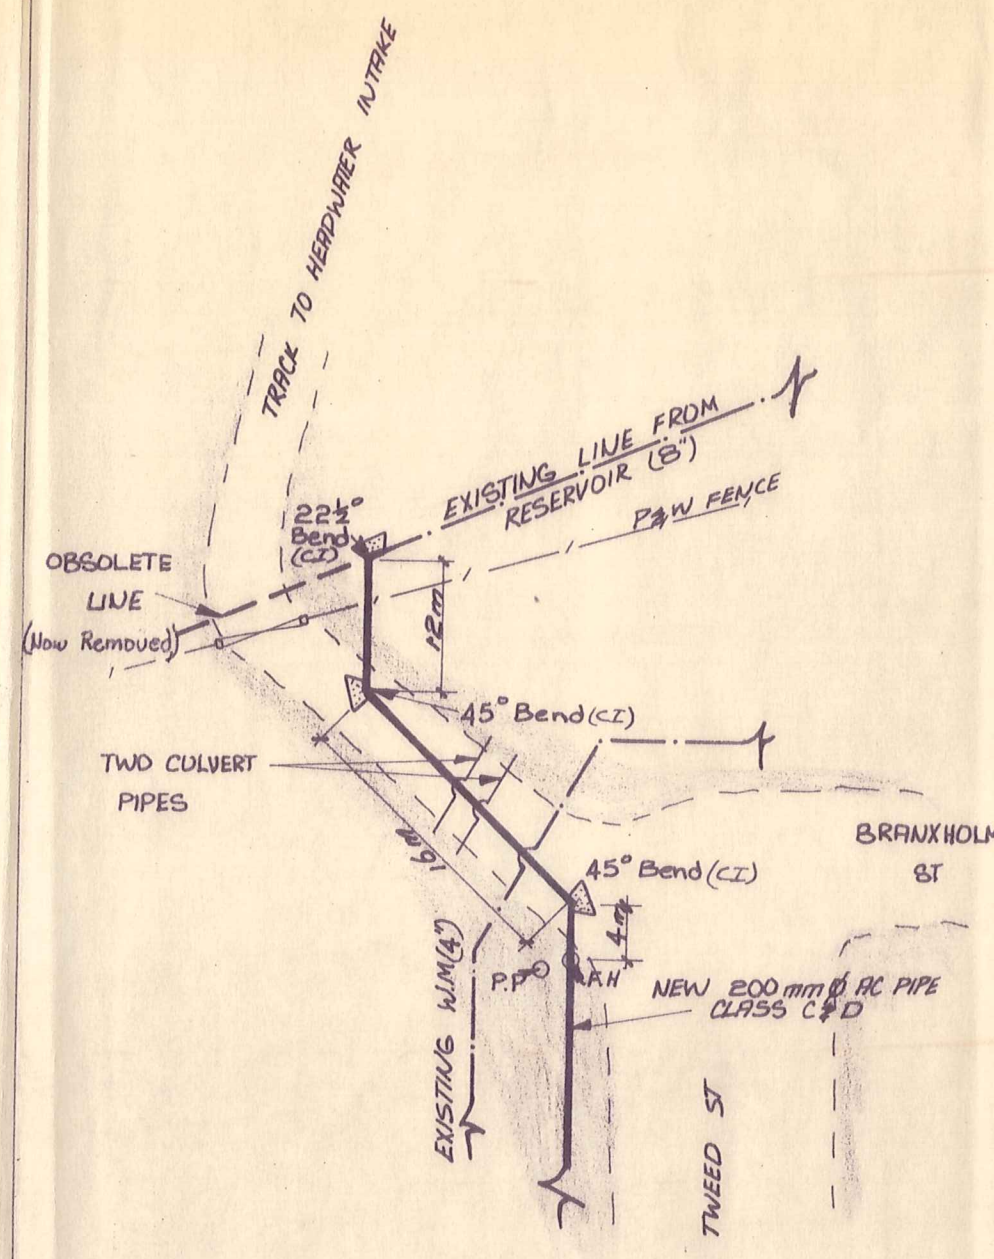


DETAIL 1

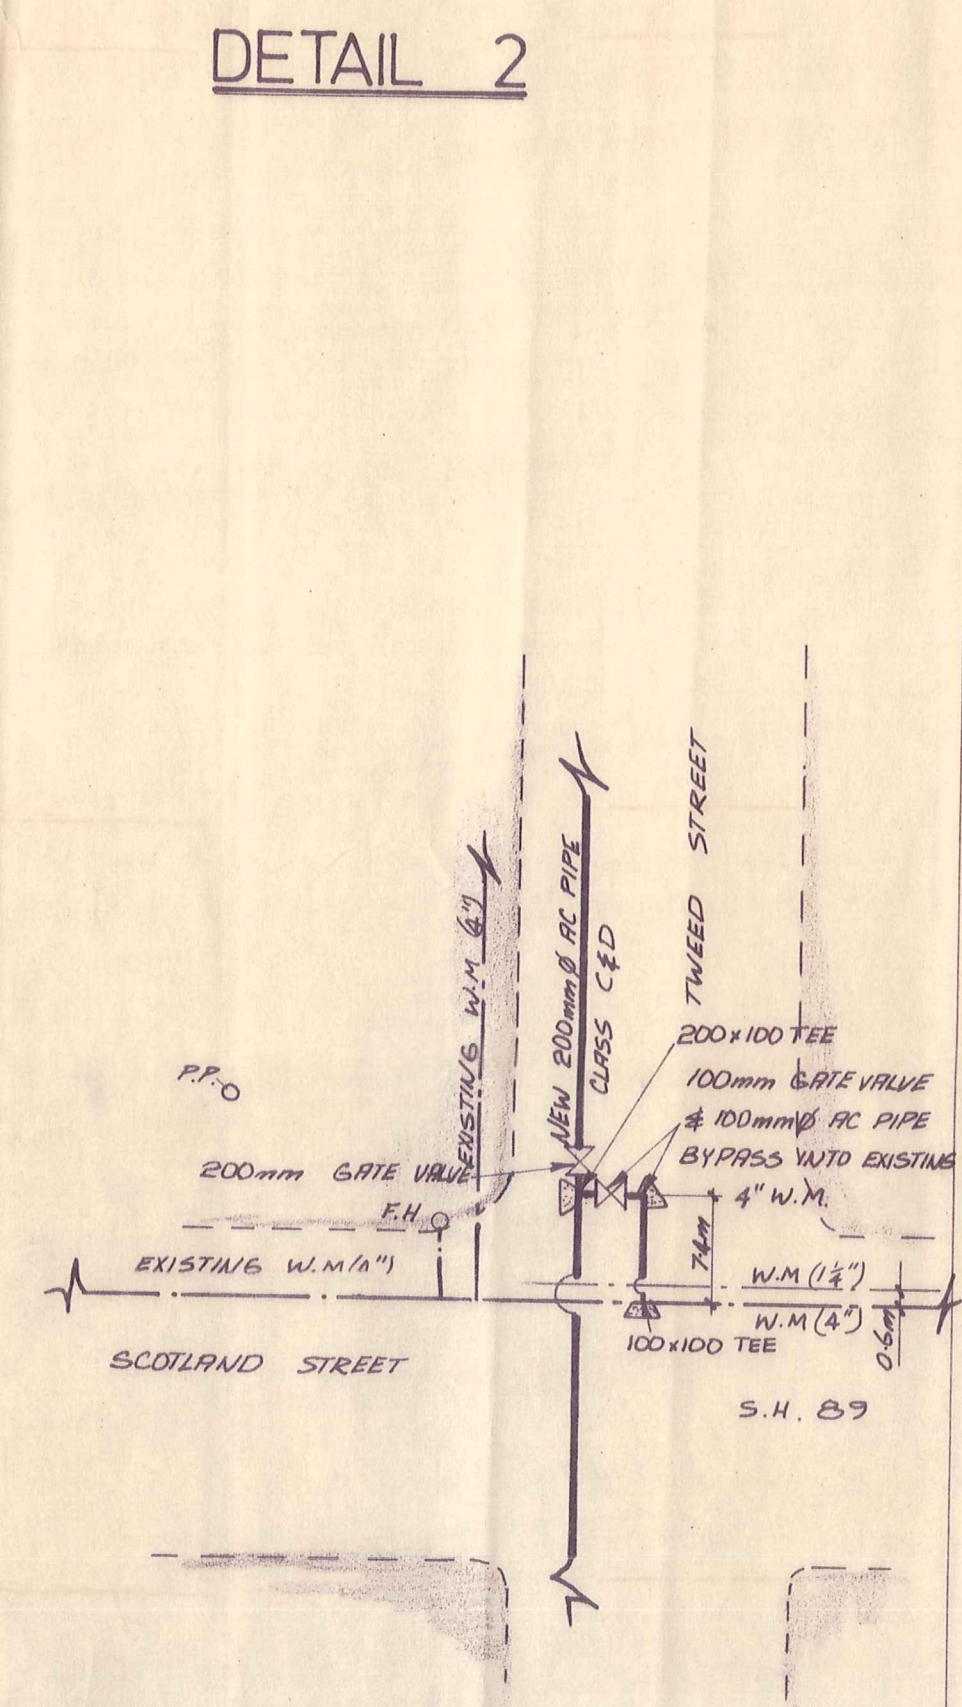


DETAIL 2

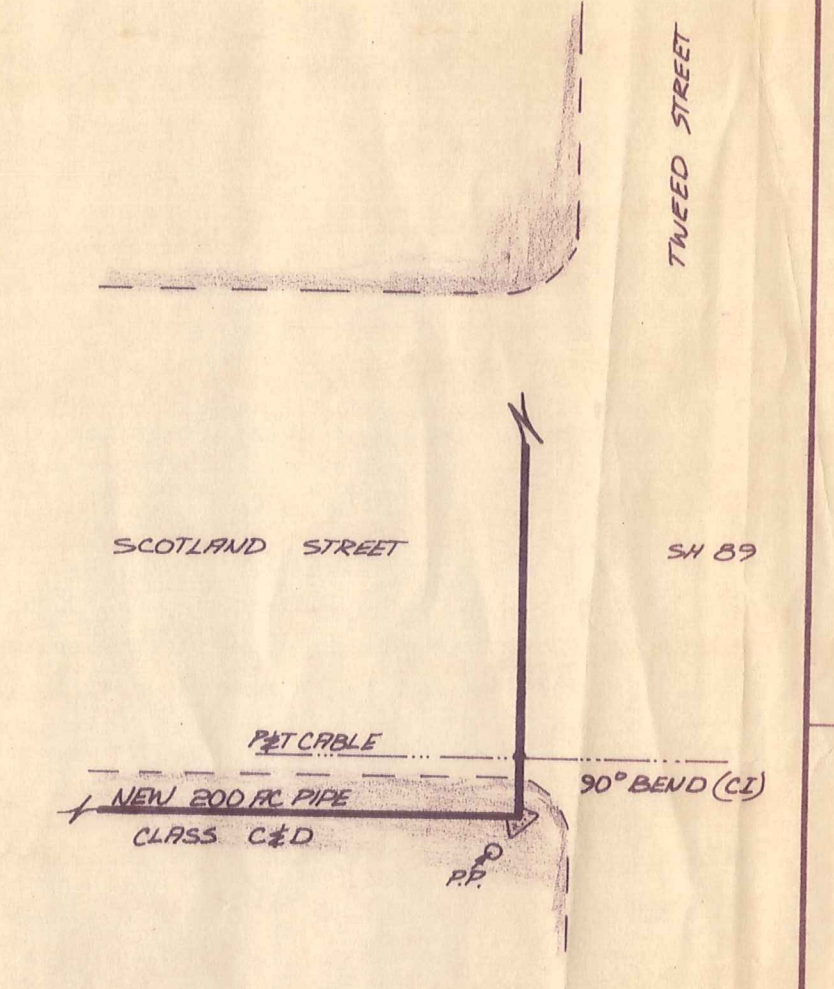


DETAIL 3

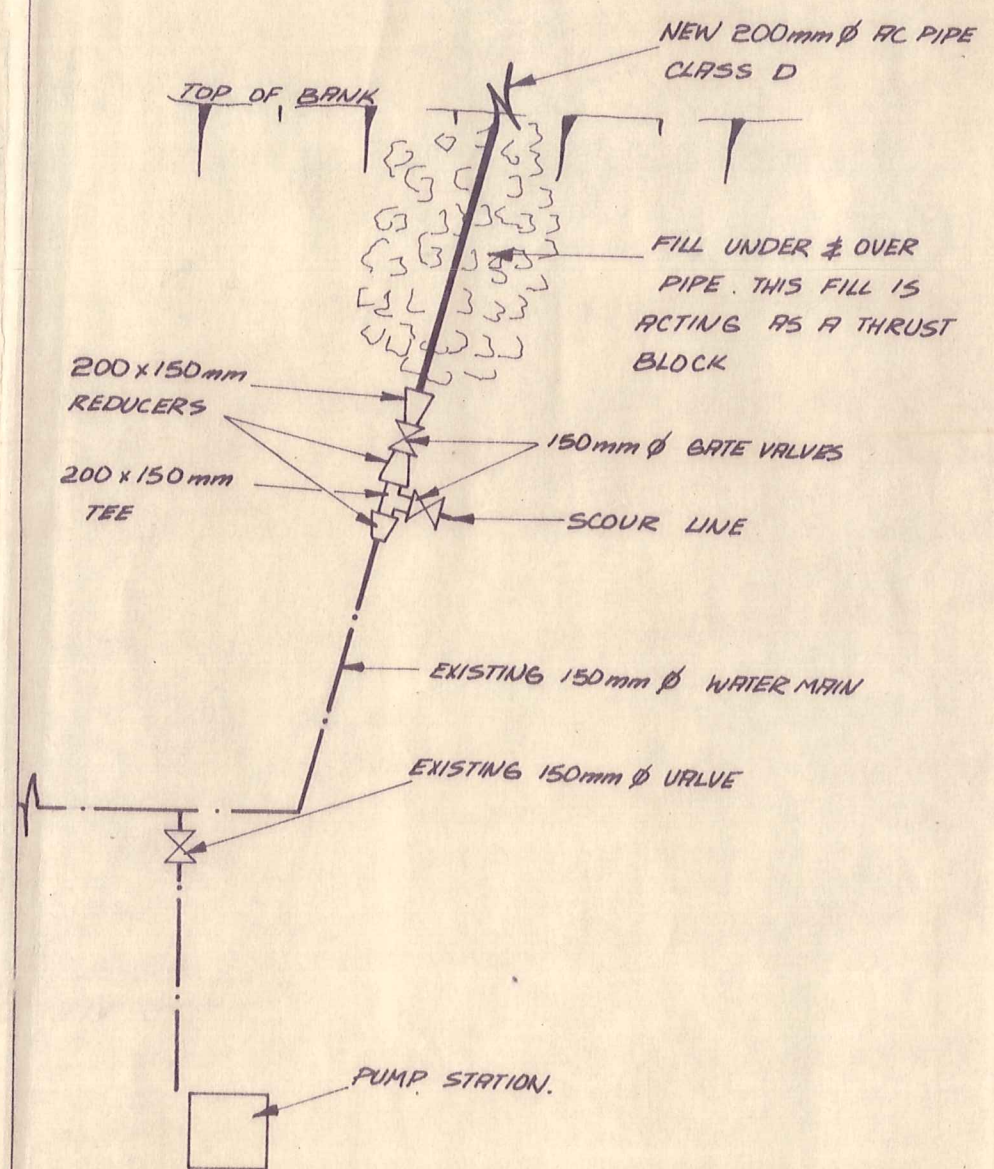

DETAIL 4

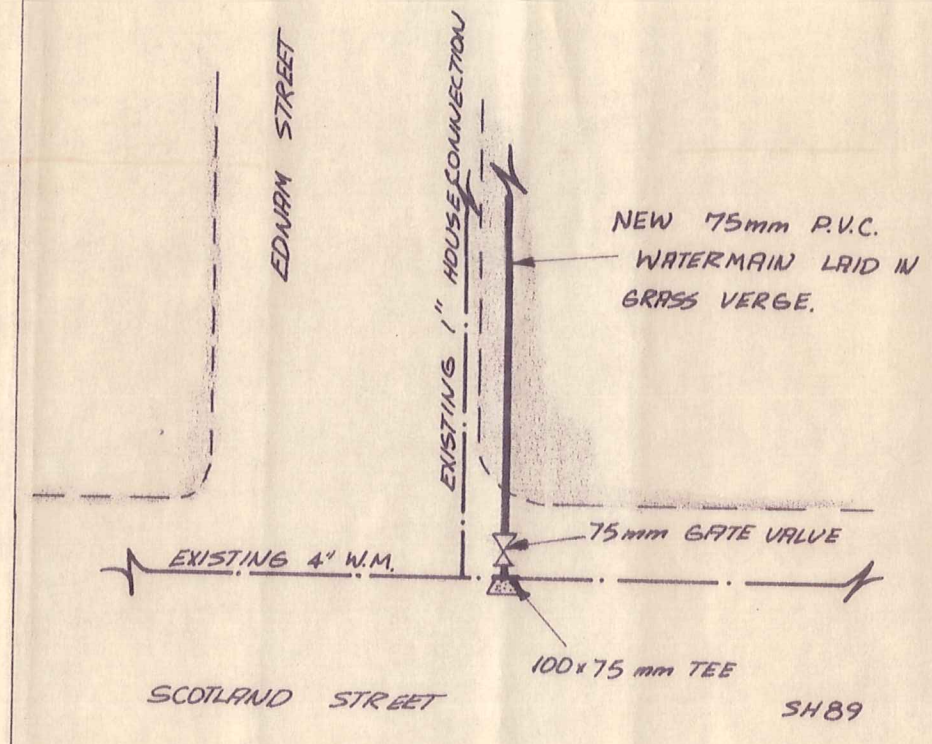

DETAIL 5

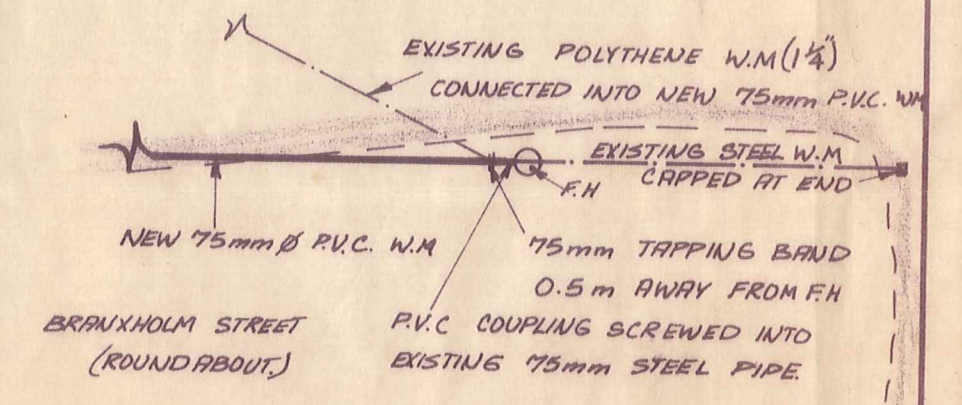

DETAIL 6

E. R. GARDEN & PARTNERS
CONSULTING ENGINEERS
DUNEDIN & INVERCARGILL

ROXBURGH BOROUGH COUNCIL

Designed	JWC	Date	NOV '78	Scale:	2Ch to 1", N.T.S.
Drawn	JWC	Job No.	3346	Traced	JWC
Checked	JWC	Survey Ref:			

NEW WATERMAIN LAID AFTER
OCTOBER 1978 FLOOD (AS BUILT)

DRG No. 3346/2

AMENDMENTS

RELEVANT DRAWINGS ETC.

Amendment

NEW WATER MAIN DESIGN