

ROXBURGH BOROUGH COUNCIL

ROXBURGH SEWERAGE SCHEME

SEWER CONNECTION RECORDS

CONTENTS

Plan	-	Showing overall sewer lines.
Index	-	Relating sewer line to page numbers and as-built record plans.
Pages 1 - 37	-	Sewer connection details.

Note

1. To find connection details for a particular house (which is connected to sewers laid in this scheme) proceed as follows:-
 2. Assume house 155 Scotland Street.
 3. From plan 3060/20 you find that the connection comes out the front of the section to Line II between MHs 50 and 51.
 4. From index details of Line II are on pages 22 to 25.
 5. On sheet 24 which shows between MH 50 and 51 you find that 155 Scotland Street is connected 47.5 metres from MH 50.
 6. Further details such as sewer depth etc, are shown on As-built plan number 3060/20.
-

INDEX

<u>Line</u>	<u>Sheet</u>	<u>Drawing</u>
B-B	1 - 3	3060/4
E-E	4 - 9	3060/16
F-F	10 - 13	3060/17
G-G	14 - 15	3060/18
H-H	16 - 21	3060/19
I-I	22 - 25	3060/20
J-J	26	3060/20
K-K	27 - 34	3060/21
L-L	35 - 36	3060/18
M-M	37	3060/18


SEWER RECORD SHEET

SHEET NO. 1

DATE 10-3-80

LOCAL AUTHORITY Roxburgh B.C. CONTRACT L - Roxburgh Sewerage
 Drawing No 3060/A Sewer Line B-B 225mm dia. Class Sewer Fibrolite pipes

AS BUILT AND EXISTING SERVICES DETAILS.

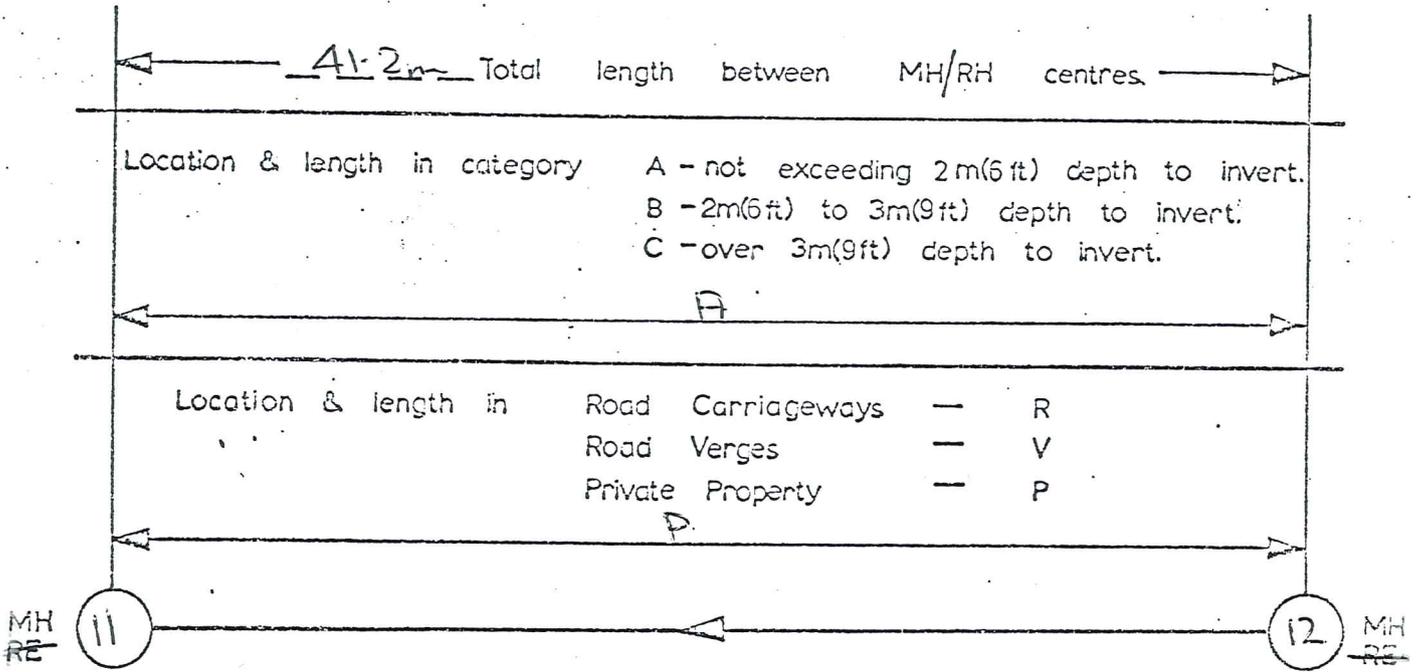

Distance	Service or Connection	Depth	Comments.
0	MH/RE 11		
21m	Connection 100mm ϕ		M ^r lockhaunts
41.2m	MH/RE 12		


Service or Connection — note saddles, Y junctions, other pipes, cables, etc.

Also type and size.

Depth — note depth to invert of pipes and services.

Comments — note surface features and/or obstructions, also Rock (type, length, width, & depth excavated) and Haunching (type & length laid)

Supplementary Sheet 2

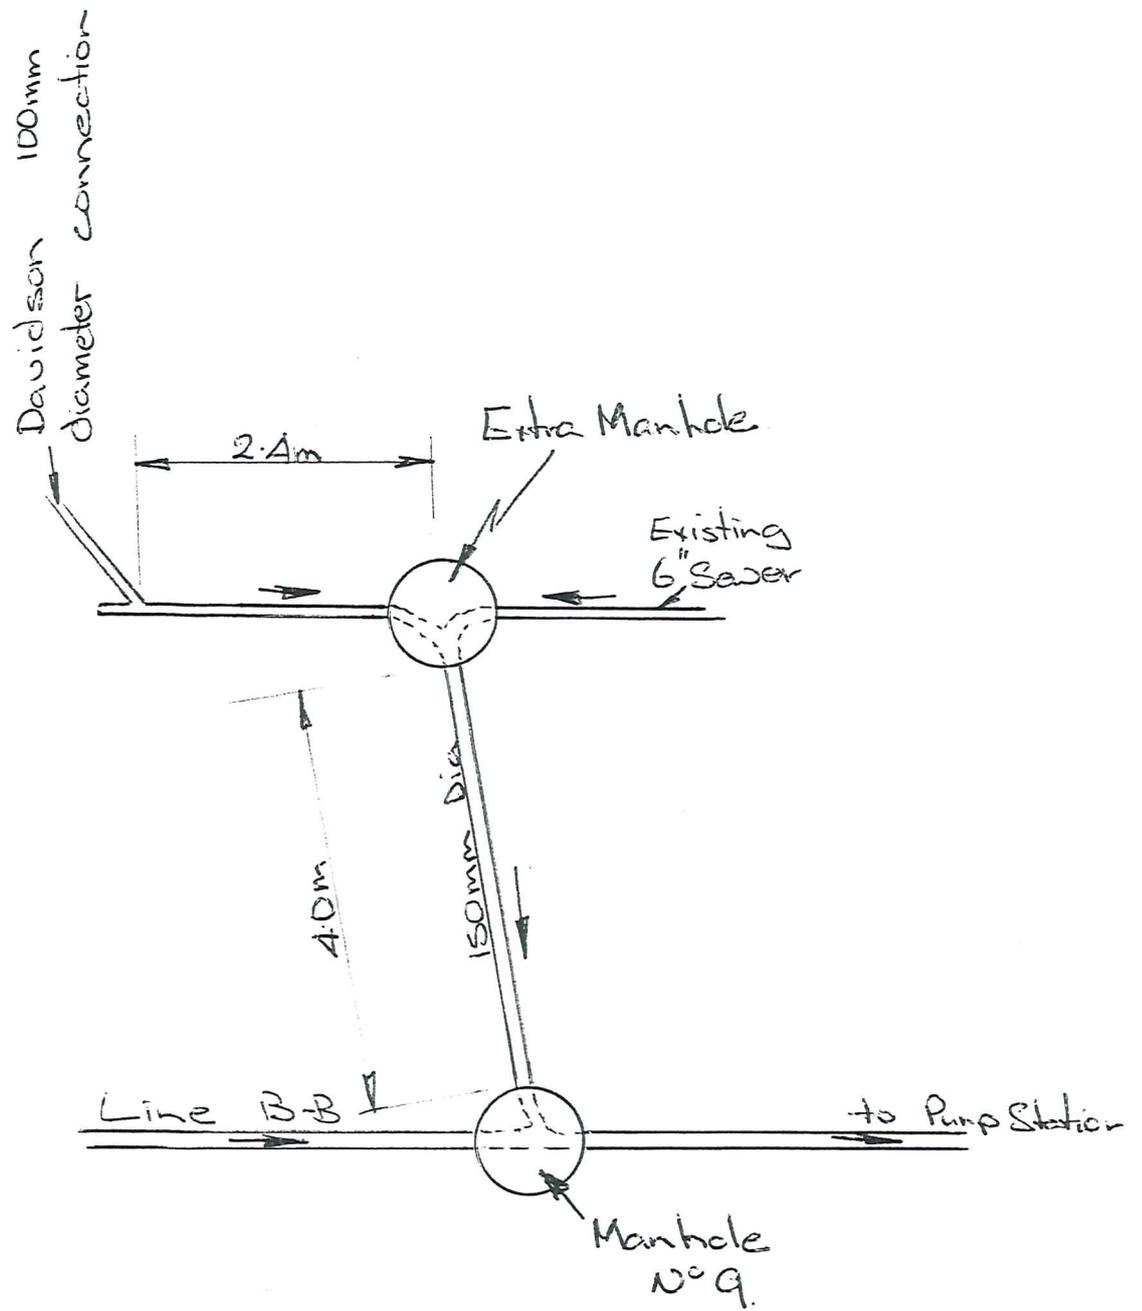


SEWER RECORD SHEET

SHEET NO. 3

DATE 10-3-80

LOCAL AUTHORITY Roxburgh B.C. CONTRACT 1 Roxburgh Sewerage
 Drawing No 3060/4 Sewer Line BB 150mm dia. Class Sewer Fibrolite pipes

AS BUILT AND EXISTING SERVICES DETAILS.

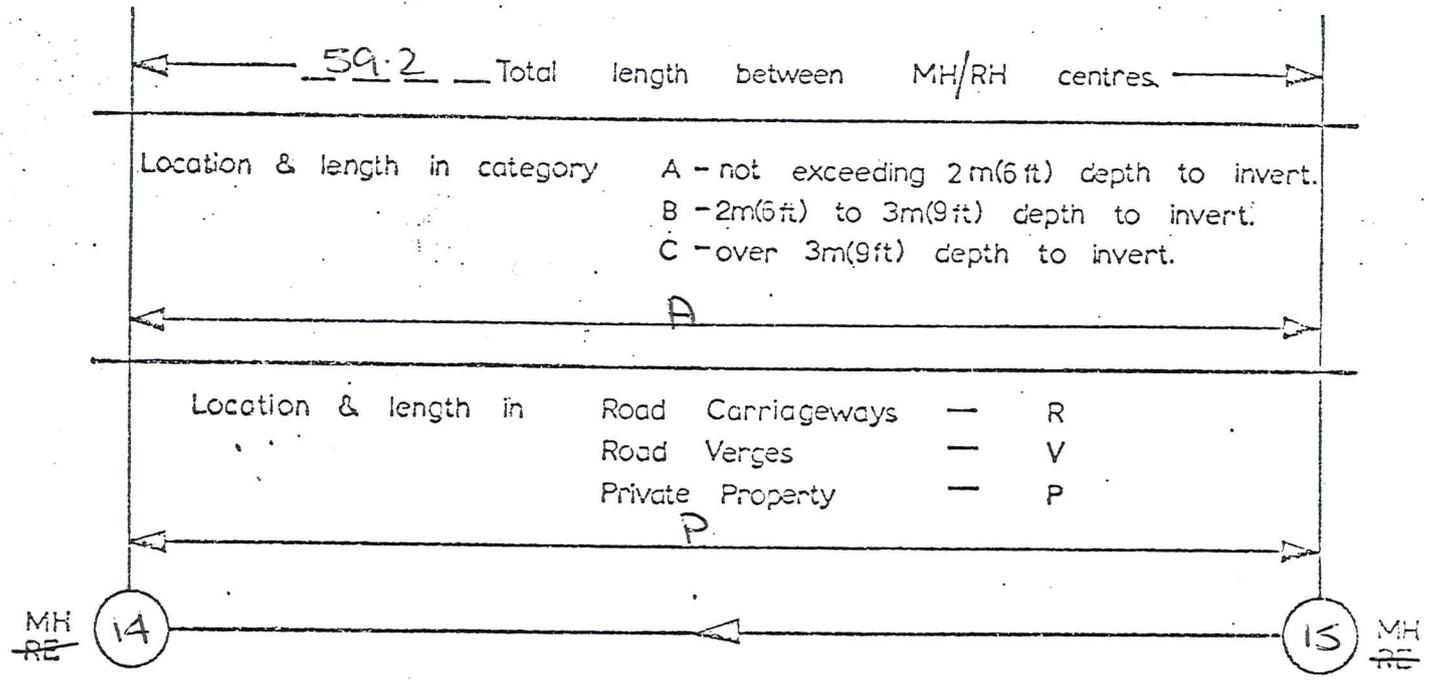

Distance	Service or Connection	Depth	Comments.
0	MH/RE 14		
57.2m	Connection 100mm		M ^r Quinns Yard.
59.2m	MH/RE 15.		

Service or Connection — note saddles, Y junctions, other pipes, cables, etc.
 Also type and size.

Depth — note depth to invert of pipes and services.

Comments — note surface features and/or obstructions,
 also Rock (type, length, width, & depth excavated) and Haunching (type & length laid)


SEWER RECORD SHEET

SHEET NO. 4

DATE 10-3-80

LOCAL AUTHORITY Roxburgh B.C. CONTRACT 3 - Roxburgh Sewerage
 Drawing No. 3060/16 Sewer Line EE 150mm dia. Class Sewer Fibrolite pipes

AS BUILT AND EXISTING SERVICES DETAILS.

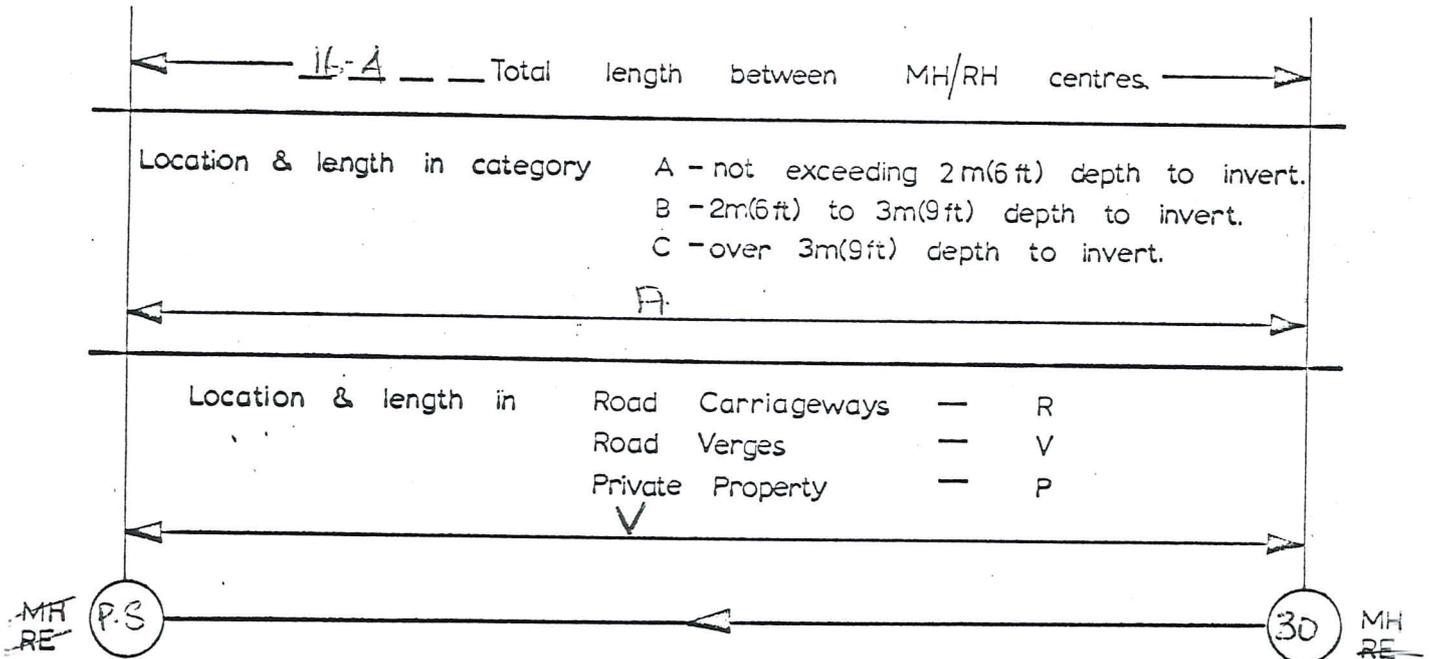

Distance	Service or Connection	Depth	Comments.
0	MH/RE Pumping Station No 1		
	100mm ϕ Connection		
	M ^r Tunnage (Electricity)		
16.4m	MH/RE 30		

Service or Connection — note saddles, Y junctions, other pipes, cables, etc.

Also type and size.

Depth — note depth to invert of pipes and services.

Comments — note surface features and/or obstructions, also Rock (type, length, width, & depth excavated) and Haunching (type & length laid)


SEWER RECORD SHEET

SHEET NO. 5

DATE 10-3-80

LOCAL AUTHORITY Roxburgh BC CONTRACT 3 - Roxburgh Sewerage
 Drawing No 3060/16 Sewer Line EE 150mm dia. Class Sewer Fibrelite pipes

AS BUILT AND EXISTING SERVICES DETAILS.

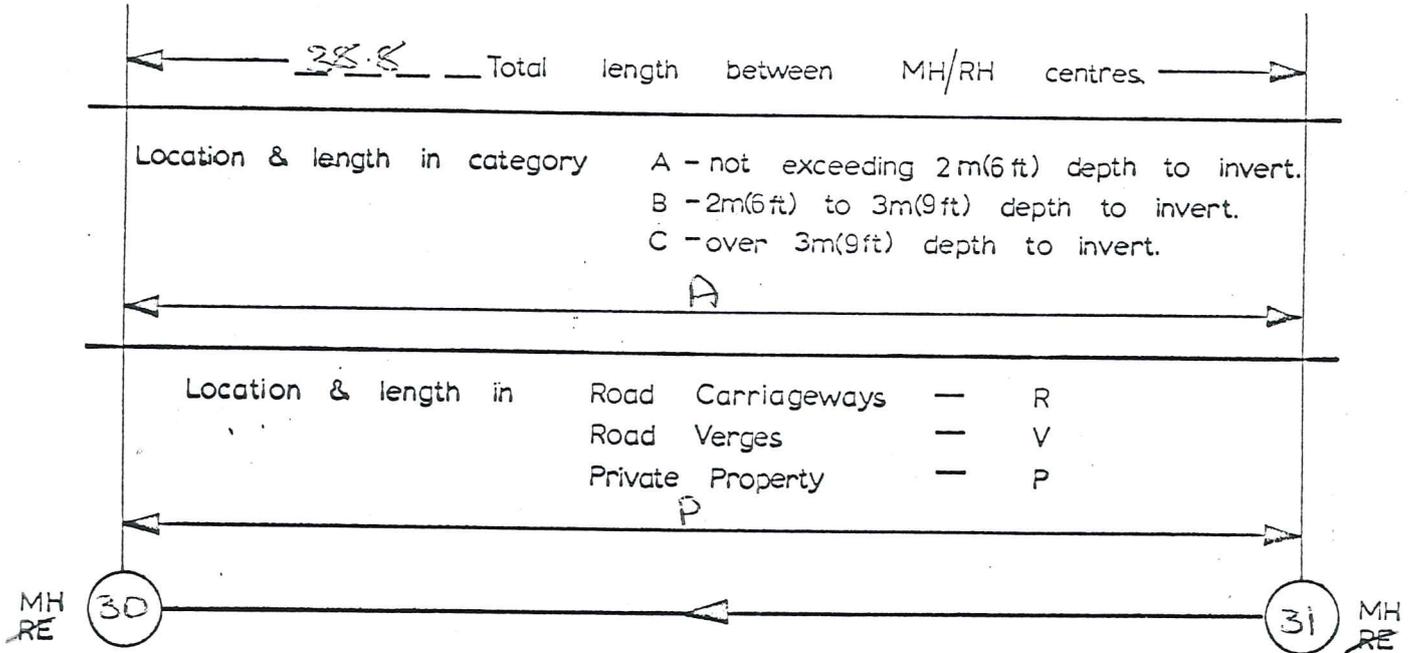

Distance	Service or Connection	Depth	Comments.
0	MH/RE 30		
<u>38.8m</u>	<u>MH/RE 31</u>		

Service or Connection — note saddles, Y junctions, other pipes, cables, etc.
 Also type and size.
 Depth — note depth to invert of pipes and services.
 Comments — note surface features and/or obstructions,
 also Rock (type, length, width, & depth excavated) and Haunching (type & length laid)


SEWER RECORD SHEET

SHEET NO. 7

DATE 10-3-80

LOCAL AUTHORITY Roxburgh B.C. CONTRACT 3 - Roxburgh Sewerage
 Drawing No 3060/16 Sewer Line E-E 150mm dia. Class Sewer Fibrolite pipes

AS BUILT AND EXISTING SERVICES DETAILS.

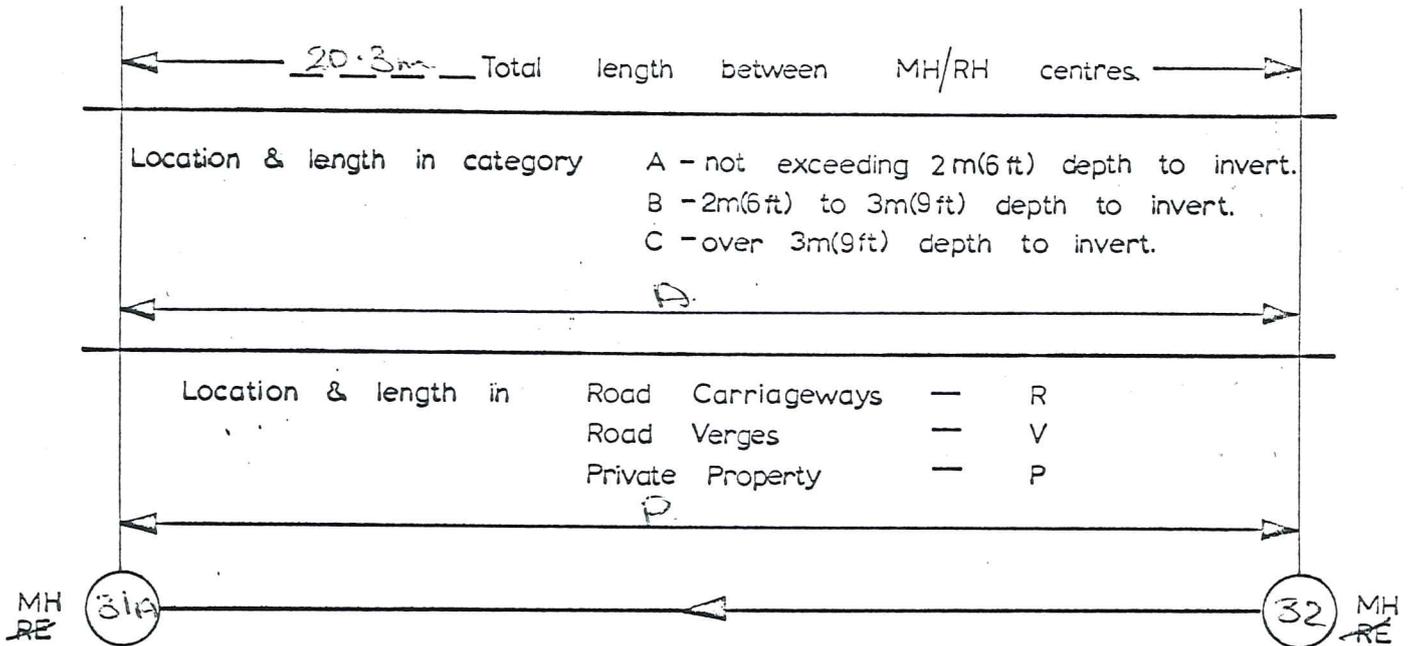

Distance	Service or Connection	Depth	Comments.
0	MH/RE 31A		
20.3m	MH/RE 32		


- Service or Connection — note saddles, Y junctions, other pipes, cables, etc. Also type and size.
- Depth — note depth to invert of pipes and services.
- Comments — note surface features and/or obstructions, also Rock (type, length, width, & depth excavated) and Haunching (type & length laid)

SEWER RECORD SHEET

SHEET NO. 9
DATE 10-3-80

LOCAL AUTHORITY Roxburgh B.C. CONTRACT 3 - Roxburgh Sewerage
Drawing No. 3060/16 Sewer Line E-E 150mm dia. Class Sewer Fibrolite pipes

AS BUILT AND EXISTING SERVICES DETAILS.

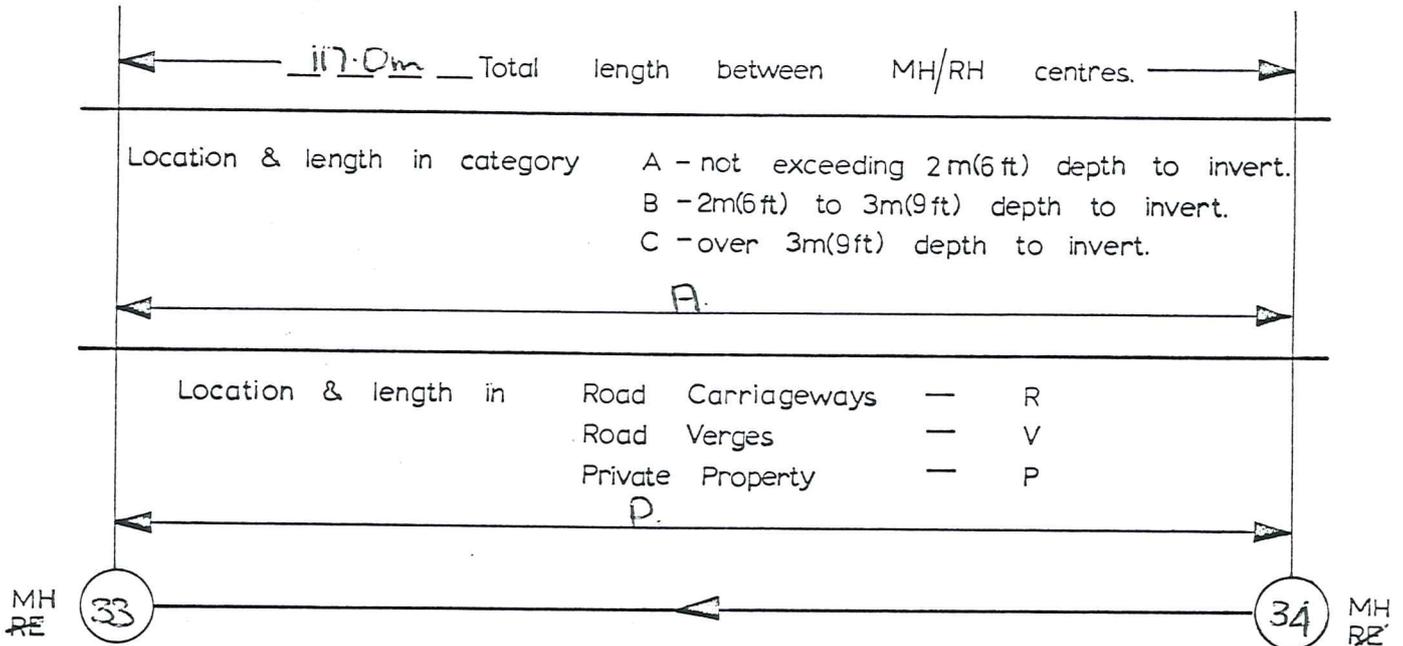

Distance	Service or Connection	Depth	Comments.
0	MH/RE 33		
<u>99.6m</u>	<u>100mm ϕ Connection</u>		
<u>117.0m</u>	<u>MH/RE 34</u>		<u>150mm ϕ Connection into Manhole</u>

- Service or Connection — note saddles, Y junctions, other pipes, cables, etc. Also type and size.
- Depth — note depth to invert of pipes and services.
- Comments — note surface features and/or obstructions, also Rock (type, length, width, & depth excavated) and Haunching (type & length laid)


SEWER RECORD SHEET

SHEET NO. 10

DATE 10-3-80

LOCAL AUTHORITY Roxburgh B.C. CONTRACT 3 - Roxburgh Sewerage
 Drawing No 3060/17 Sewer Line F-E 150mm dia. Class Sewer Fibrolite pipes

AS BUILT AND EXISTING SERVICES DETAILS.

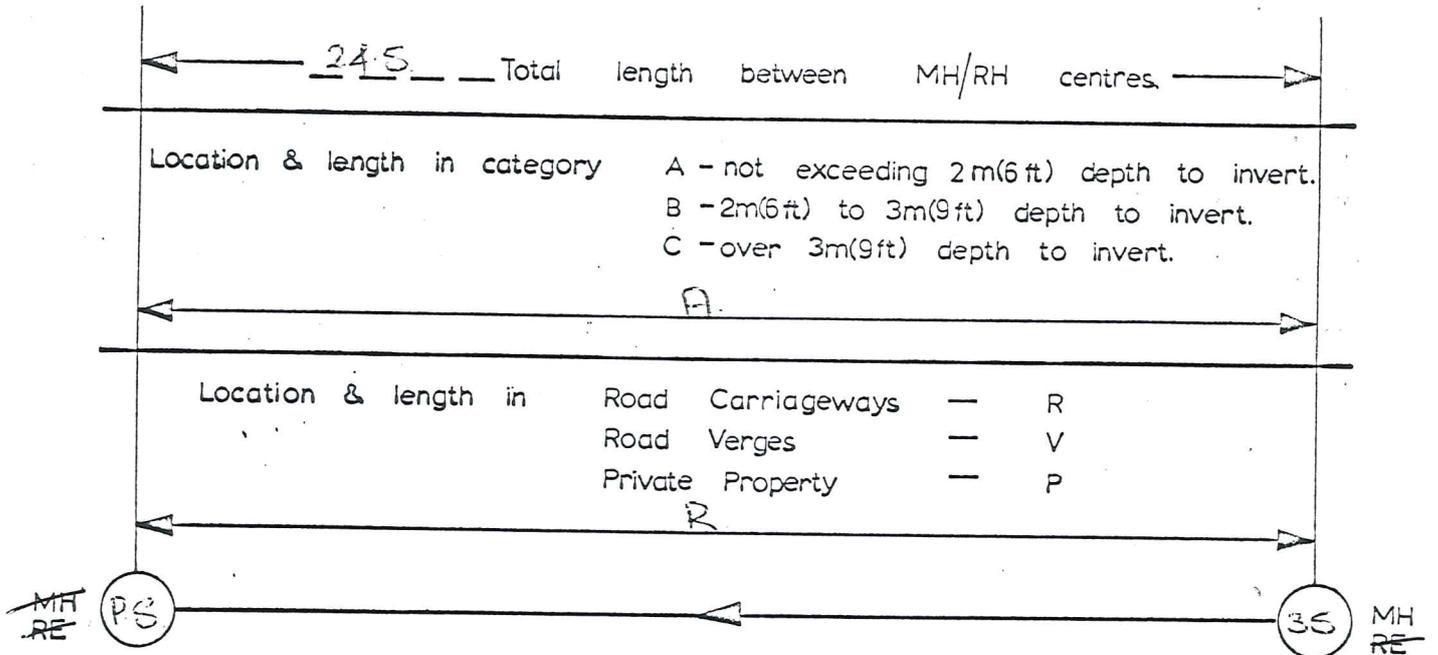

Distance	Service or Connection	Depth	Comments.
0	MH/RE Pumping Station No 1		
24.5m	MH/RE 35.		100mm ϕ extg Sewer connected to Manhole


- Service or Connection — note saddles, Y junctions, other pipes, cables, etc. Also type and size.
- Depth — note depth to invert of pipes and services.
- Comments — note surface features and/or obstructions, also Rock (type, length, width, & depth excavated) and Haunching (type & length laid)

SEWER RECORD SHEET

SHEET NO. 12
DATE 10-3-80

LOCAL AUTHORITY Roxburgh B.C. CONTRACT 3- Roxburgh Sewerage
Drawing No. 3062/17 Sewer Line F-F 150mm dia. Class 3000 Fibrelite pipes

AS BUILT AND EXISTING SERVICES DETAILS.

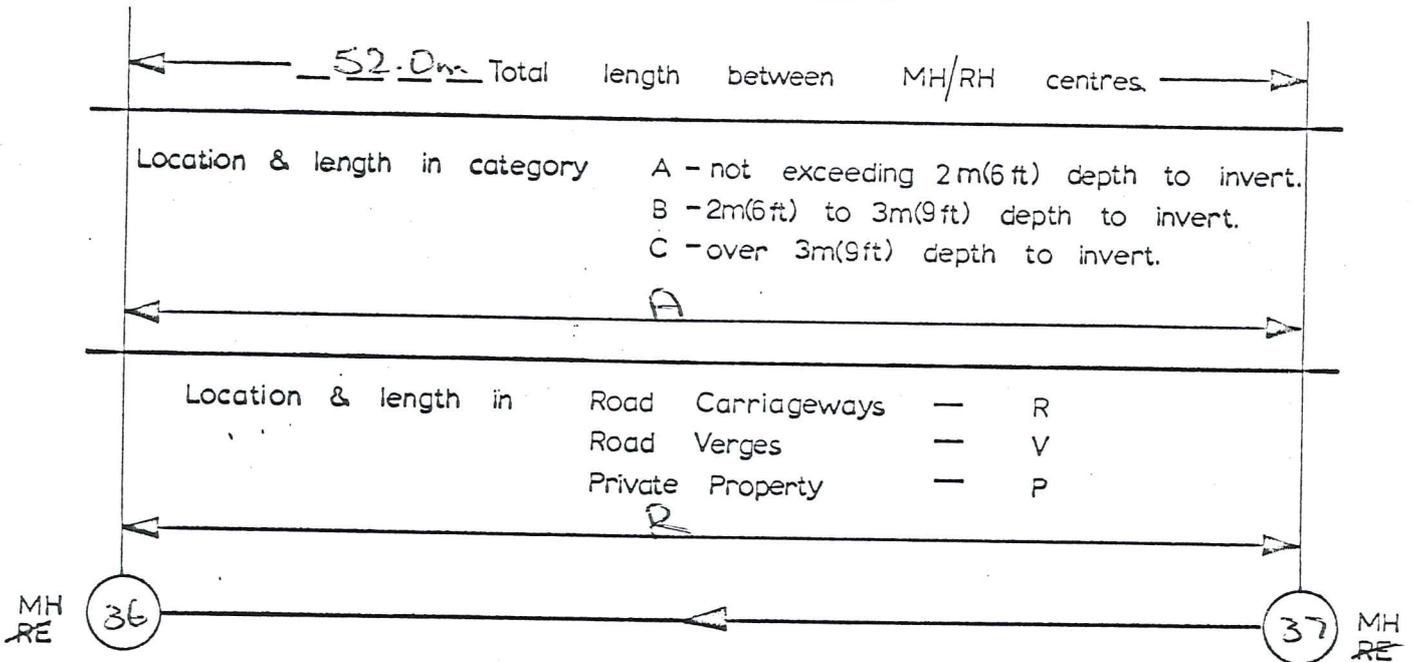

Distance	Service or Connection	Depth	Comments.
0	MH/RE 36		
52.0m	MH/RE 37		100mm connection into Man hole.

- Service or Connection — note saddles, Y junctions, other pipes, cables, etc. Also type and size.
- Depth — note depth to invert of pipes and services.
- Comments — note surface features and/or obstructions, also Rock (type, length, width, & depth excavated) and Haunching (type & length laid)


SEWER RECORD SHEET

SHEET NO. 13

DATE 10-3-80

LOCAL AUTHORITY Roxburgh B.C. CONTRACT 3-Roxburgh Sewerage
 Drawing No 3060/17 Sewer Line FE 150mm dia. Class Sewer Fibrelite pipes

AS BUILT AND EXISTING SERVICES DETAILS.

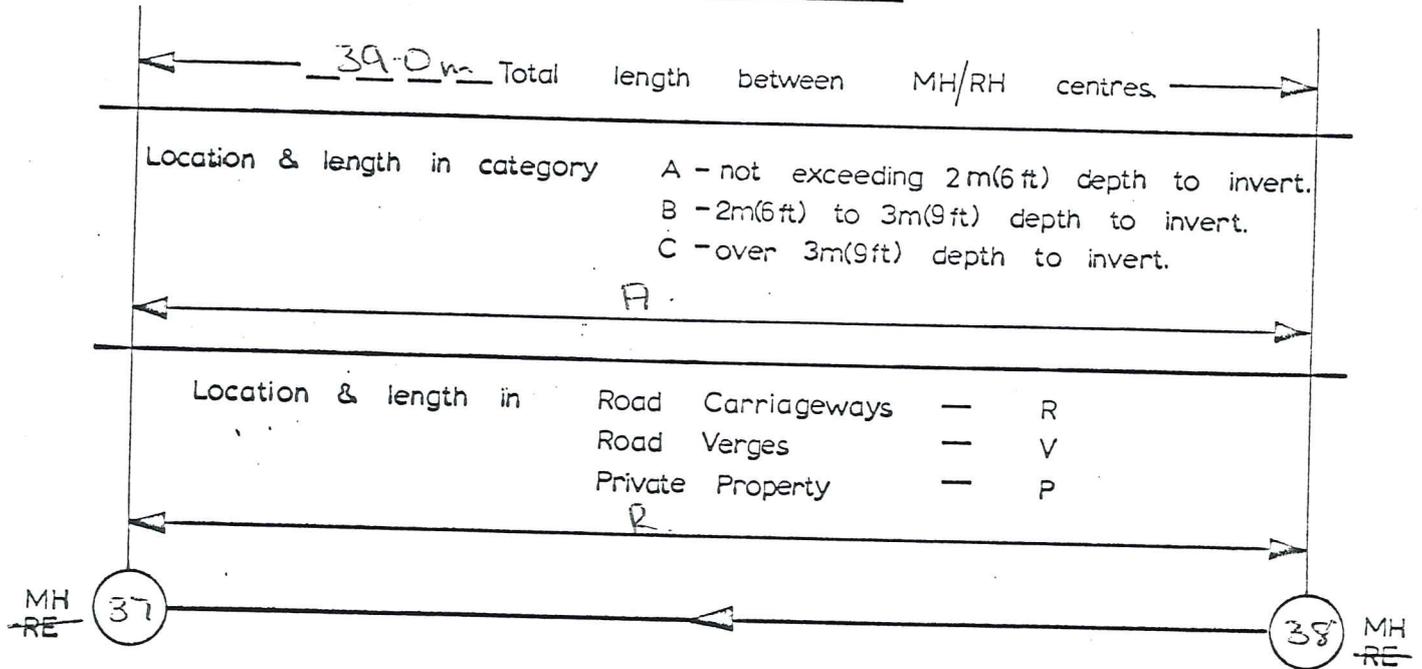

Distance	Service or Connection	Depth	Comments.
0	MH/RE 37		
<u>39.0m</u>	<u>MH/RE 38</u>		<u>100mm Ø exty Sewer Connected to Manhole.</u>

- Service or Connection — note saddles, Y junctions, other pipes, cables, etc. Also type and size.
- Depth — note depth to invert of pipes and services.
- Comments — note surface features and/or obstructions, also Rock (type, length, width, & depth excavated) and Haunching (type & length laid)


SEWER RECORD SHEET

SHEET NO. 14

DATE 5-3-80

LOCAL AUTHORITY Roxburgh B.C. CONTRACT 3 - Roxburgh Sewerage
 Drawing No. 3060/18 Sewer Line G.G. 150mm dia. Class sewer - P.V.C. pipes

AS BUILT AND EXISTING SERVICES DETAILS.

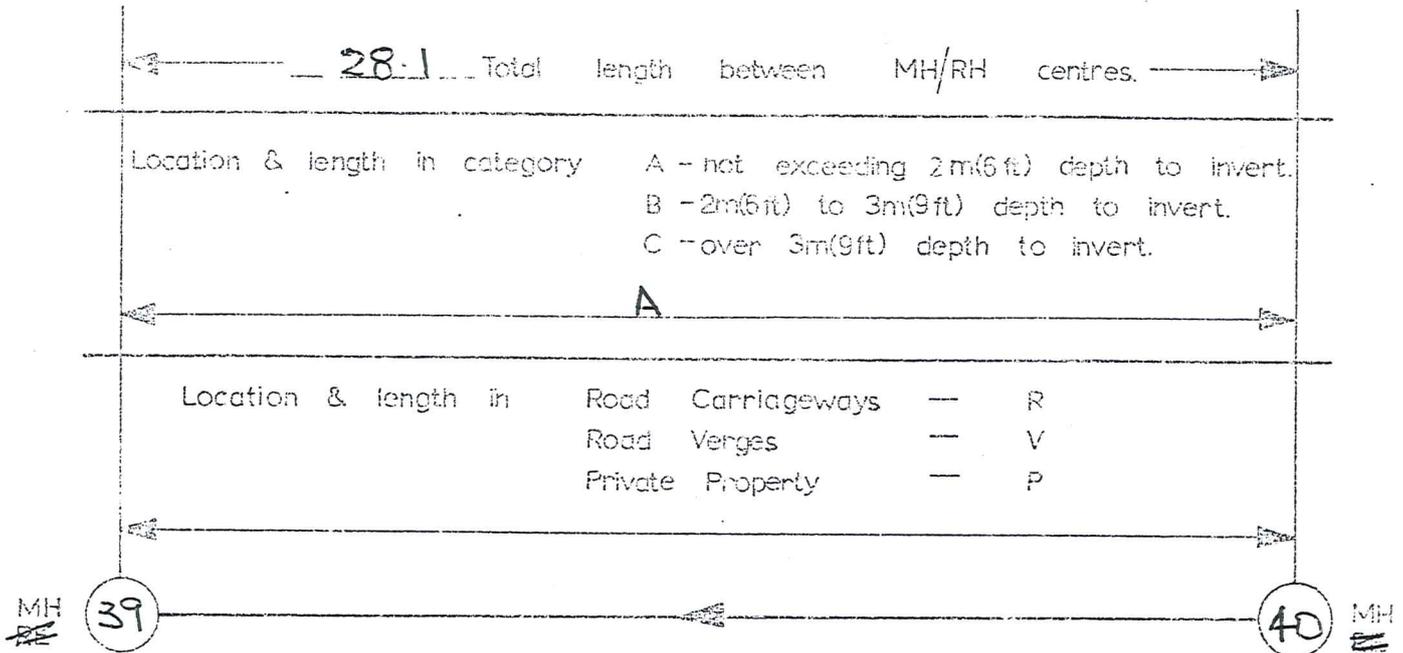

Distance	Service or Connection	Depth	Comments.
0	MH/ RH 39		
10.7	sewer connection	1.0m	Chemist Shop
28.1	MH/ RH 40		

Service or Connection — note saddles, Y junctions, other pipes, cables, etc.
 Also type and size.
 Depth — note depth to invert of pipes and services.
 Comments — note surface features and/or obstructions,
 also Rock (type, length, width, & depth excavated) and Haunching (type & length laid)


SEWER RECORD SHEET

SHEET NO. 15

DATE 5-3-80

LOCAL AUTHORITY Roxburgh B.C. CONTRACT 3 - Roxburgh Sewerage
 Drawing No 3060/18 Sewer Line GG 150mm dia. Class sewer P.V.C. pipes

AS BUILT AND EXISTING SERVICES DETAILS.

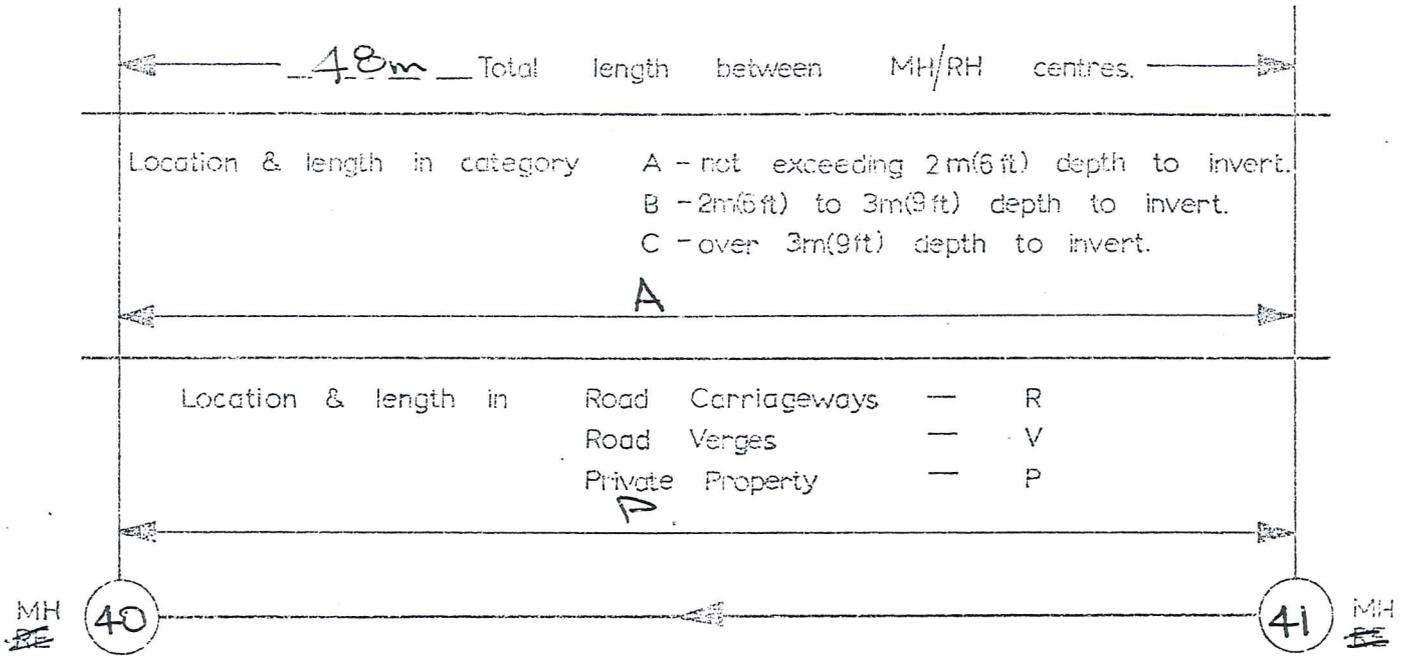

Distance	Service or Connection	Depth	Comments
0	MH 40		
6.3m	sewer connection	0.8	N° 85 Scotland St
8.1m	"	0.8	N° 83 Scotland St
22.0m	"	0.8	House shown on B' Kelso St
30.0m	"	1.0	Play Centre, Scotland St
35.6m	"	0.8	House shown on A' Abbotsford St
0.0m	Connection into MH 40		House shown on C' Kelso St
48.0m	MH 41		

Service or Connection — note saddles, Y junctions, other pipes, cables, etc.
 Also type and size.

Depth — note depth to invert of pipes and services.


Comments — note surface features and/or obstructions,
 also Rock (type, length, width, & depth excavated) and Haunching (type & length laid)

SEWER RECORD SHEET

SHEET NO. 16
DATE 10-3-80

LOCAL AUTHORITY Roxburgh B.C. CONTRACT 3- Roxburgh Sewerage
Drawing No 3060/19 Sewer Line H-H 150mm dia. Class Sewer Fibrolite pipes

AS BUILT AND EXISTING SERVICES DETAILS.

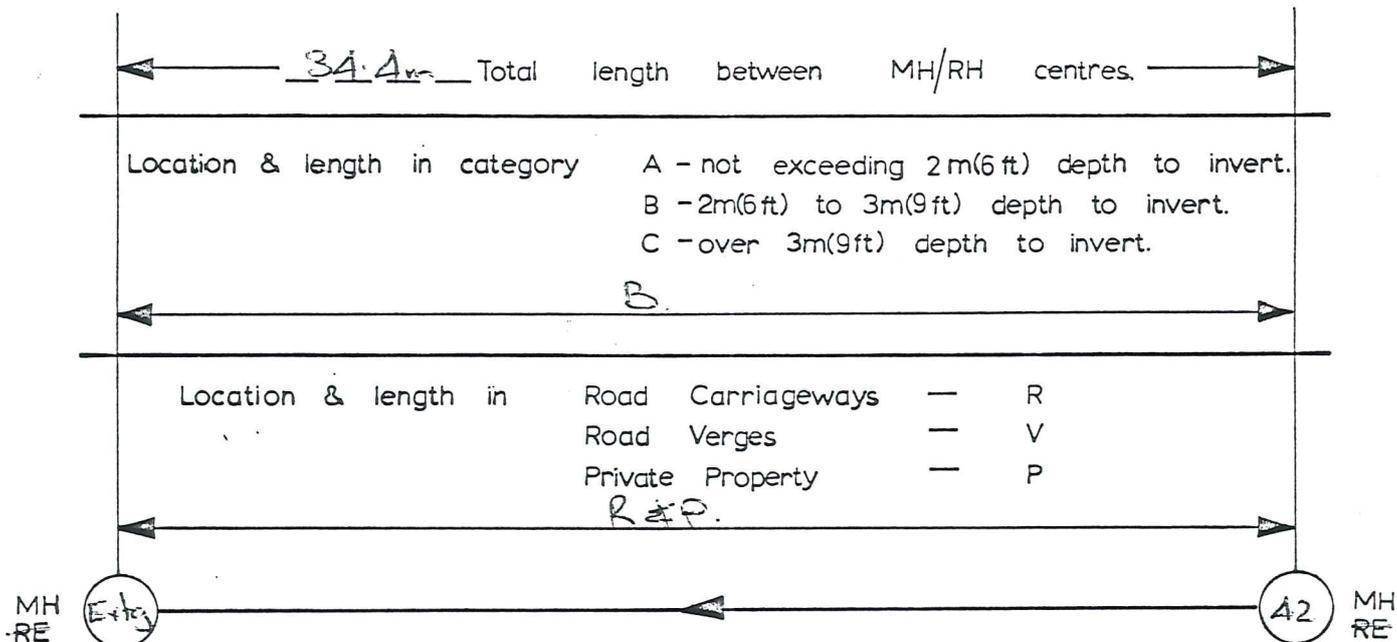

Distance	Service or Connection	Depth	Comments.
0	MH/RE <u>Ety</u>		
<u>25m</u>	<u>100mm ϕ Sewer Connection.</u>		<u>14m in side Bdy at Jedburgh St. House No 32.</u>
<u>34.4m</u>	MH/RE <u>42</u>		

Service or Connection — note saddles, Y junctions, other pipes, cables, etc.

Also type and size.

Depth — note depth to invert of pipes and services.

Comments — note surface features and/or obstructions, also Rock (type, length, width, & depth excavated) and Haunching (type & length laid)


SEWER RECORD SHEET

SHEET NO. 17

DATE 10-3-80

LOCAL AUTHORITY Roxburgh B.C. CONTRACT 3 - Roxburgh Sewerage
 Drawing No 3060/19 Sewer Line H-H 150mm dia. Class Sewer Fibrelite pipes

AS BUILT AND EXISTING SERVICES DETAILS.

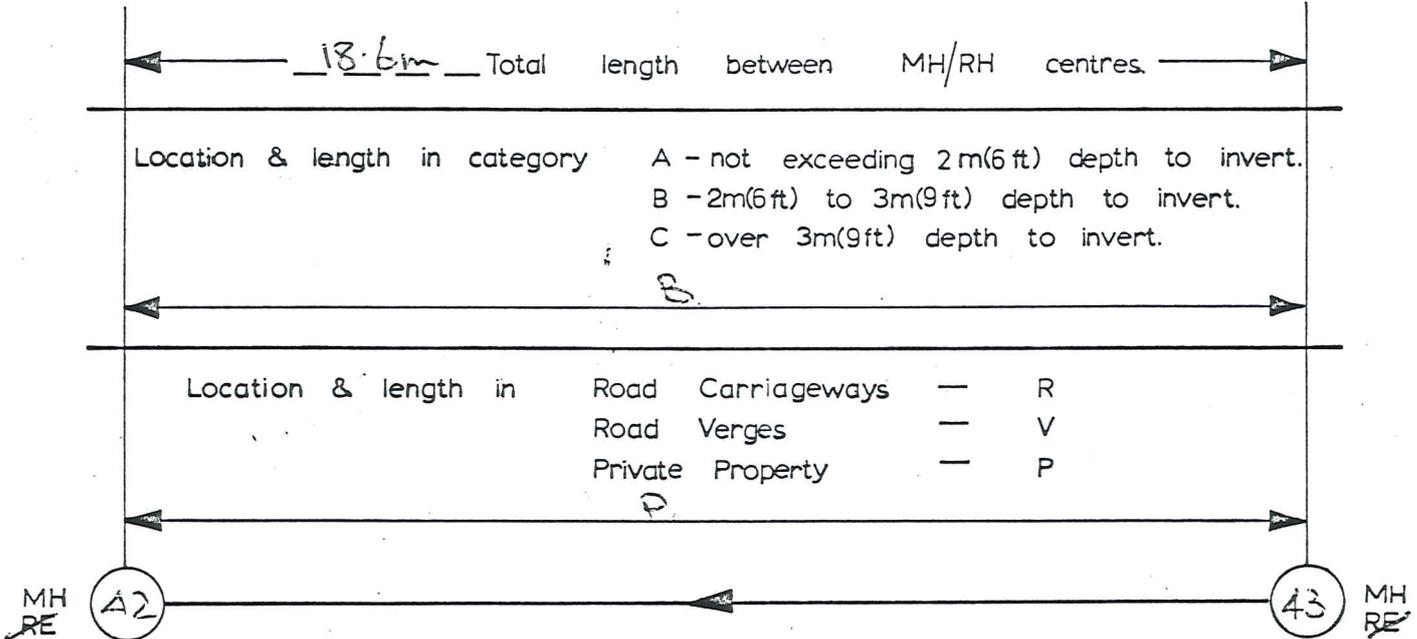

Distance	Service or Connection	Depth	Comments.
0	MH/RE 42		
0	Connection		100mm ϕ House NO 28
11.7m	Connection		100mm ϕ House NO 30
12.6m	Connection		100mm ϕ House NO 26
18.6m	MH/RE 43		

- Service or Connection — note saddles, Y junctions, other pipes, cables, etc. Also type and size.
- Depth — note depth to invert of pipes and services.
- Comments — note surface features and/or obstructions, also Rock (type, length, width, & depth excavated) and Haunching (type & length laid)


SEWER RECORD SHEET

SHEET NO. 18

DATE 10-3-80

LOCAL AUTHORITY Roxburgh B.C. CONTRACT 3 - Roxburgh Sewerage
 Drawing No 3060/A Sewer Line H-H 150mm dia. Class Sever Fibrolite pipes

AS BUILT AND EXISTING SERVICES DETAILS.

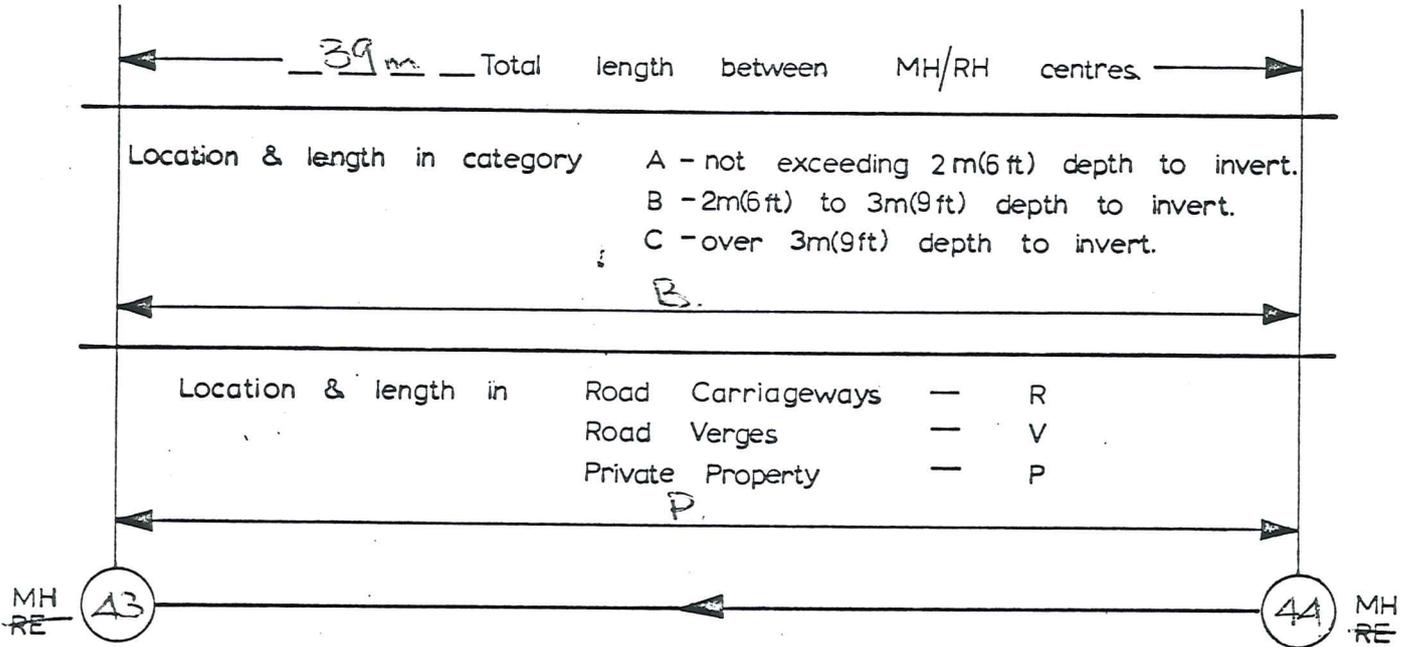

Distance	Service or Connection	Depth	Comments.
0	MH/RE 43		
13.2m	Connection		100mm ϕ Inspection 1.3m from fence (N ^o 129)
17.3m	Connection		100mm ϕ Inspection 3.5m from fence (N ^o 131)
23m	Connection		100mm ϕ Inspection 2.0m from fence (N ^o 135)
23.7m	Connection		100mm ϕ Inspection 3.9m from fence (N ^o 133)
31.3m	Connection		100mm ϕ Inspection 5.1m from fence (N ^o 133 Scotland St)
39m	MH/RE 44		

Service or Connection — note saddles, Y junctions, other pipes, cables, etc.

Also type and size.

Depth — note depth to invert of pipes and services.

Comments — note surface features and/or obstructions, also Rock (type, length, width, & depth excavated) and Haunching (type & length laid)


SEWER RECORD SHEET

SHEET NO. 19

DATE 10-3-80

LOCAL AUTHORITY Roxburgh B.C. CONTRACT 3 Roxburgh Sewerage
 Drawing No 3060/19 Sewer Line H-H 150mm dia. Class Sewer Fibrelite pipes

AS BUILT AND EXISTING SERVICES DETAILS.

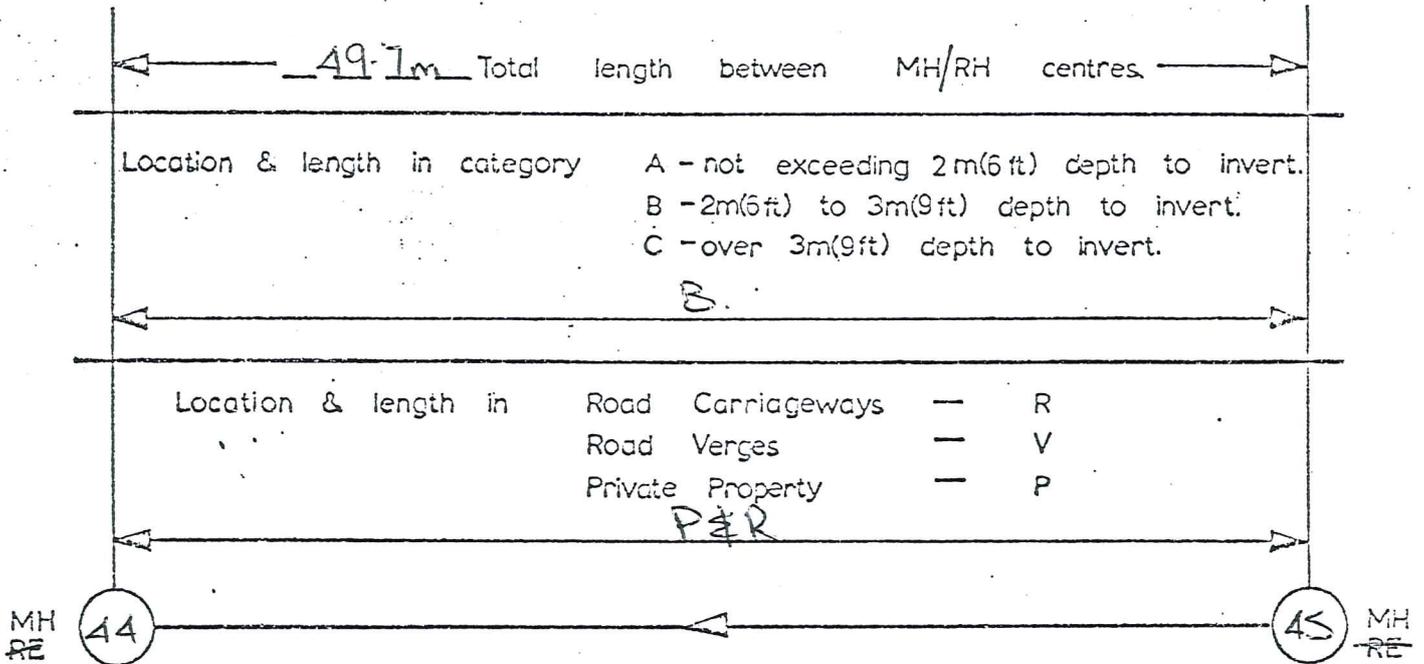

Distance	Service or Connection	Depth	Comments.
0	MH/RE 44		
12.7 m	Connection		100mm (House No 137 Scotia St)
14.6 m	Connection 100mm		Inspection 1.8hr Sewer. (House No 135 Branxholme St)
46.3 m	Connection		100mm & Inspection (House No 139 Branxholme St)
48.2 m	Connection		100mm & Inspection (Roxburgh Market)
49.7 m	MH/RE 45		

- Service or Connection — note saddles, Y junctions, other pipes, cables, etc. Also type and size.
- Depth — note depth to invert of pipes and services.
- Comments — note surface features and/or obstructions, also Rock (type, length, width, & depth excavated) and Haunching (type & length laid)


SEWER RECORD SHEET

SHEET NO. 20

DATE 10-3-80

LOCAL AUTHORITY Roxburgh B.C. CONTRACT 3 Roxburgh Sewerage
 Drawing No 3060/19 Sewer Line H-H 150mm dia. Class Sewer Fibrolite pipes

AS BUILT AND EXISTING SERVICES DETAILS.

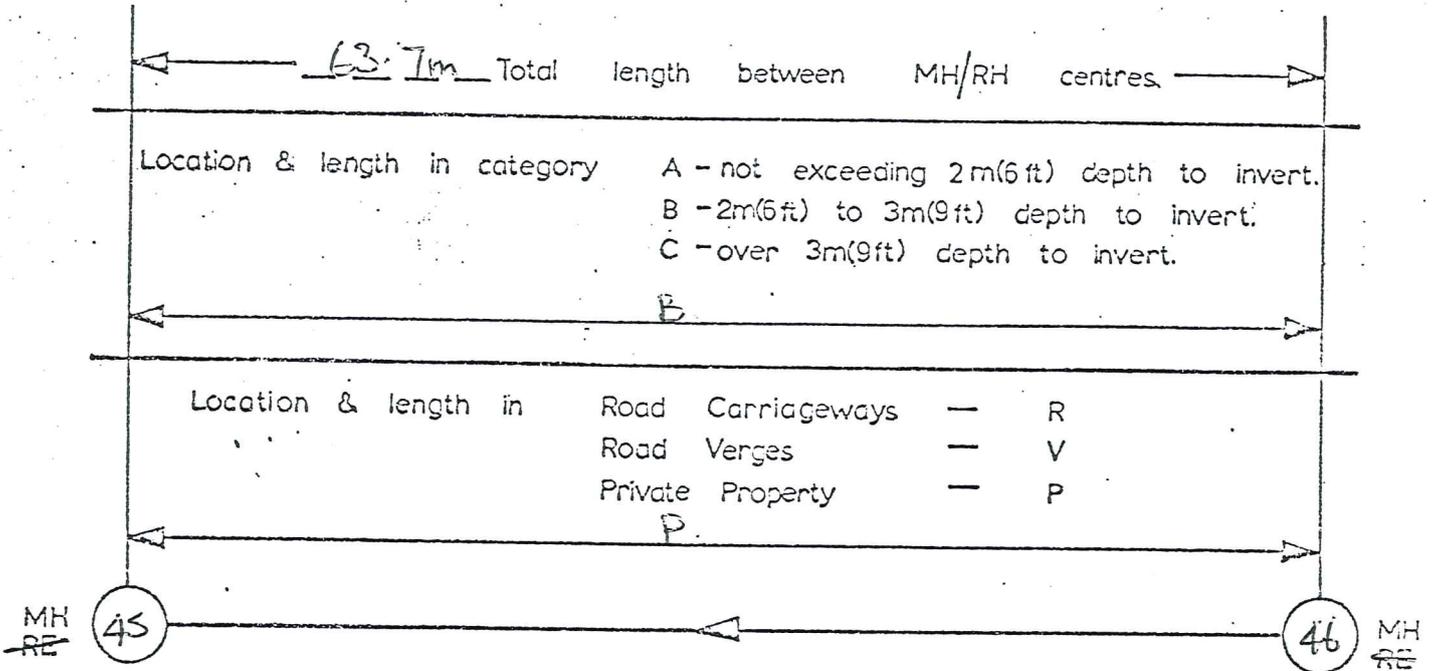


Distance	Service or Connection	Depth	Comments.
0	MH/RE 45		
22.4m	Connection		100mm ϕ inspection of Sewer, 22.7m long
			Connection with inspection @ End
40.9m	Connection		100mm ϕ Inspection
			1.0m of Sewer (House No 143 Benschelm St)
55.2m	Connection		100mm ϕ (House No 143 Scotland St)
55.9m	Connection		100mm ϕ (House No 145 Benschelm St)
			Benschelm St Scotland St
			House Nos 147 & 149
63.7m	MH/RE 46		2x 100mm ϕ Connection

Refer Supplementary Sheet No 21

- Service or Connection — note saddles, Y junctions, other pipes, cables, etc. Also type and size.
- Depth — note depth to invert of pipes and services.
- Comments — note surface features and/or obstructions, also Rock (type, length, width, & depth excavated) and Haunching (type & length laid)

Supplementary Sheet N°21

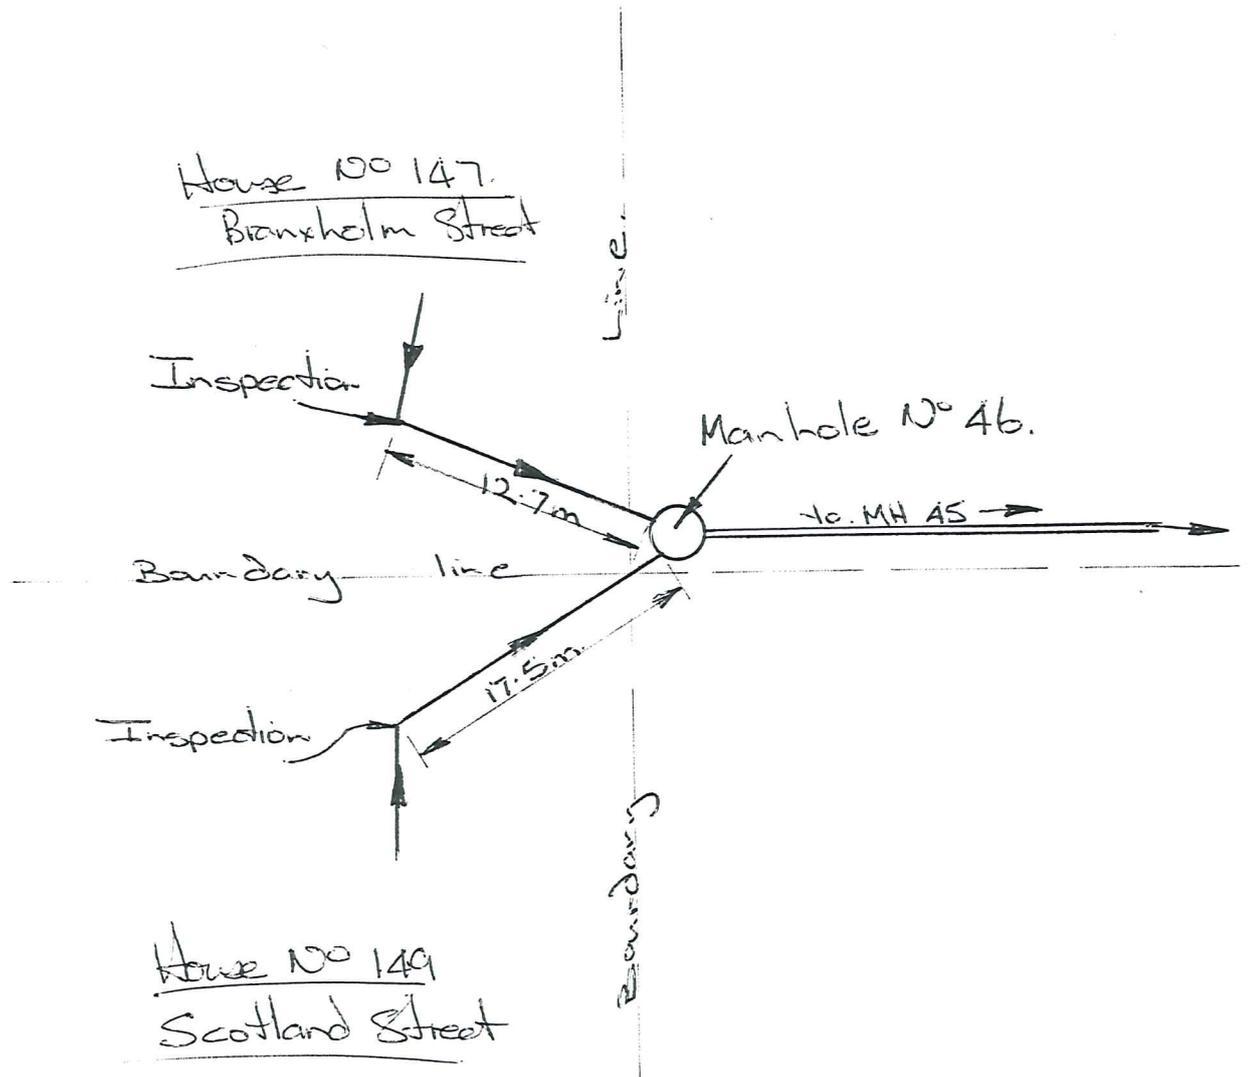


SEWER RECORD SHEET

SHEET NO 23

DATE 7-3-80

LOCAL AUTHORITY Roxburgh B.C. CONTRACT Roxburgh Sewerage
 Drawing No. 3060/20 Sewer Line II 150 dia. Class sewer fibre pipes

AS BUILT AND EXISTING SERVICES DETAILS.

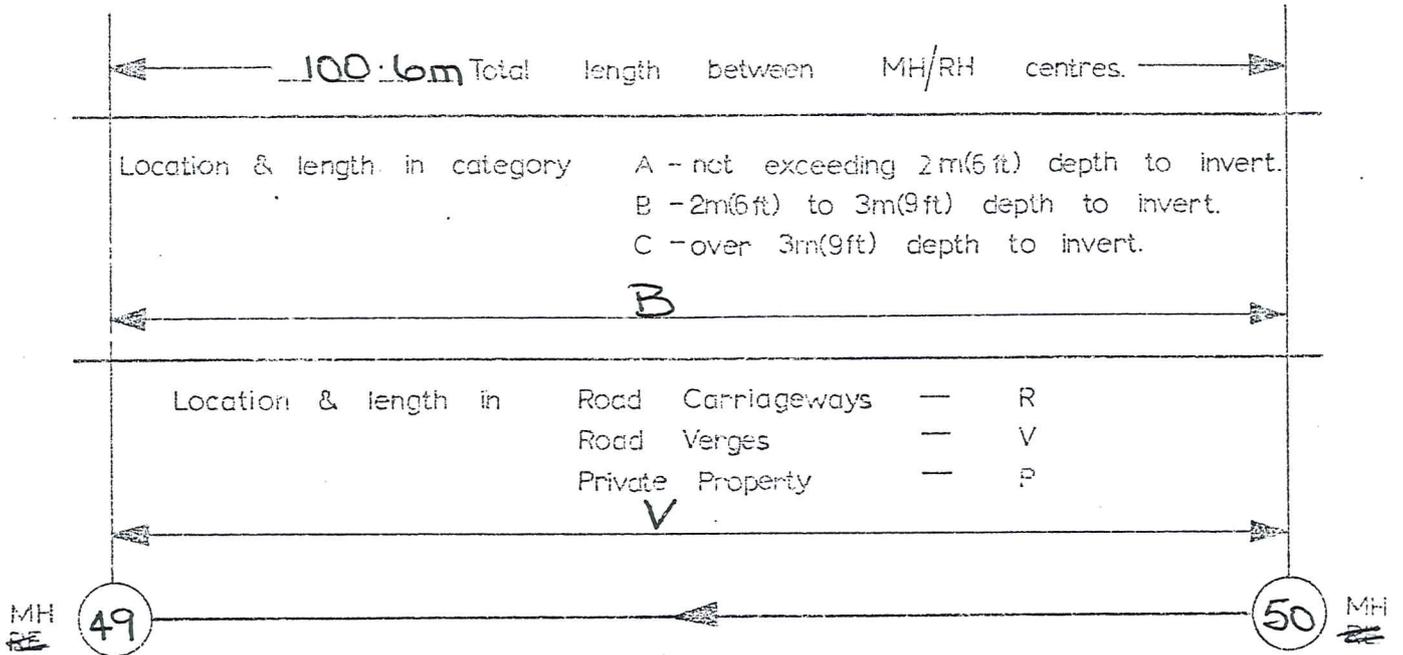

Distance	Service or Connection	Depth	Comments.
0	MH/RE <u>49</u>		
<u>38.3</u>	<u>Connection</u>		<u>House No 167 Scotland St</u>
<u>47.9</u>	"		<u>House No 165 " "</u>
<u>83.2</u>	"		<u>House No 163 " "</u>
<u>100.6m</u>	MH/RE <u>50</u>		

- Service or Connection — note saddles, Y junctions, other pipes, cables, etc. Also type and size.
- Depth — note depth to invert of pipes and services.
- Comments — note surface features and/or obstructions, also Rock (type, length, width, & depth excavated) and Haunching (type & length laid)


SEWER RECORD SHEET

SHEET NO 24

DATE 7-3-80

LOCAL AUTHORITY Roxburgh B.C. CONTRACT 3 - Roxburgh Sewerage.
 Drawing No. 3060/20 Sewer Line II 150 dia. Class sewer Fibrolite pipes

AS BUILT AND EXISTING SERVICES DETAILS.

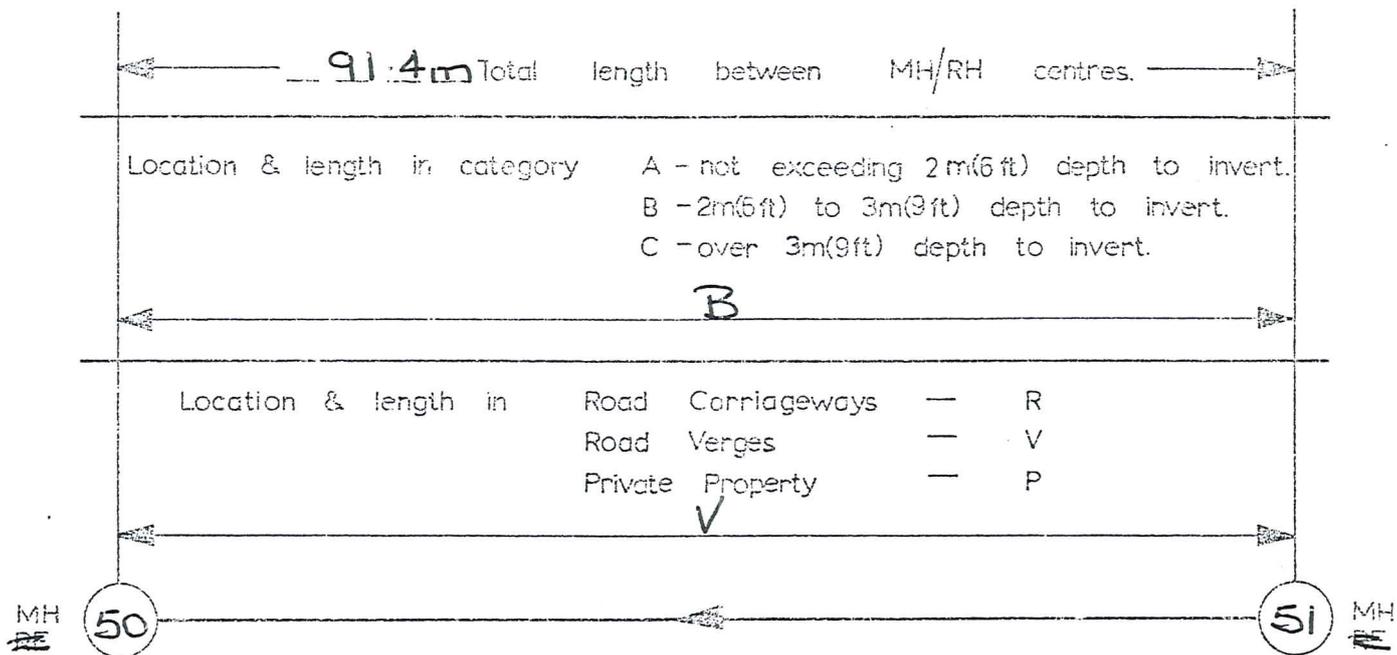

Distance	Service or Connection	Depth	Comments.
0	MH/50		
7.3	Connection		House N° 159 Scotland St
28.0	"		" " 157 " "
47.5	"		" " 155 " "
71.0	"		" " 153 " "
0	"		Into Manhole N° 50
			House N° 161 Scotland St.
91.4	MH/51		(Overflow From P.S. No. 3, 5.2m long from this manhole to adjacent extg. Manhole.)


- Service or Connection — note saddles, Y junctions, other pipes, cables, etc. Also type and size.
- Depth — note depth to invert of pipes and services.
- Comments — note surface features and/or obstructions, also Rock (type, length, width, & depth excavated) and Haunching (type & length laid)

SEWER RECORD SHEET

SHEET NO. 25
DATE 7-3-80

LOCAL AUTHORITY Roxburgh B.C. CONTRACT 3 - Roxburgh Sewerage
Drawing No. 3060/20 Sewer Line II 150 dia. Class sewer fibre/glass pipes

AS BUILT AND EXISTING SERVICES DETAILS.

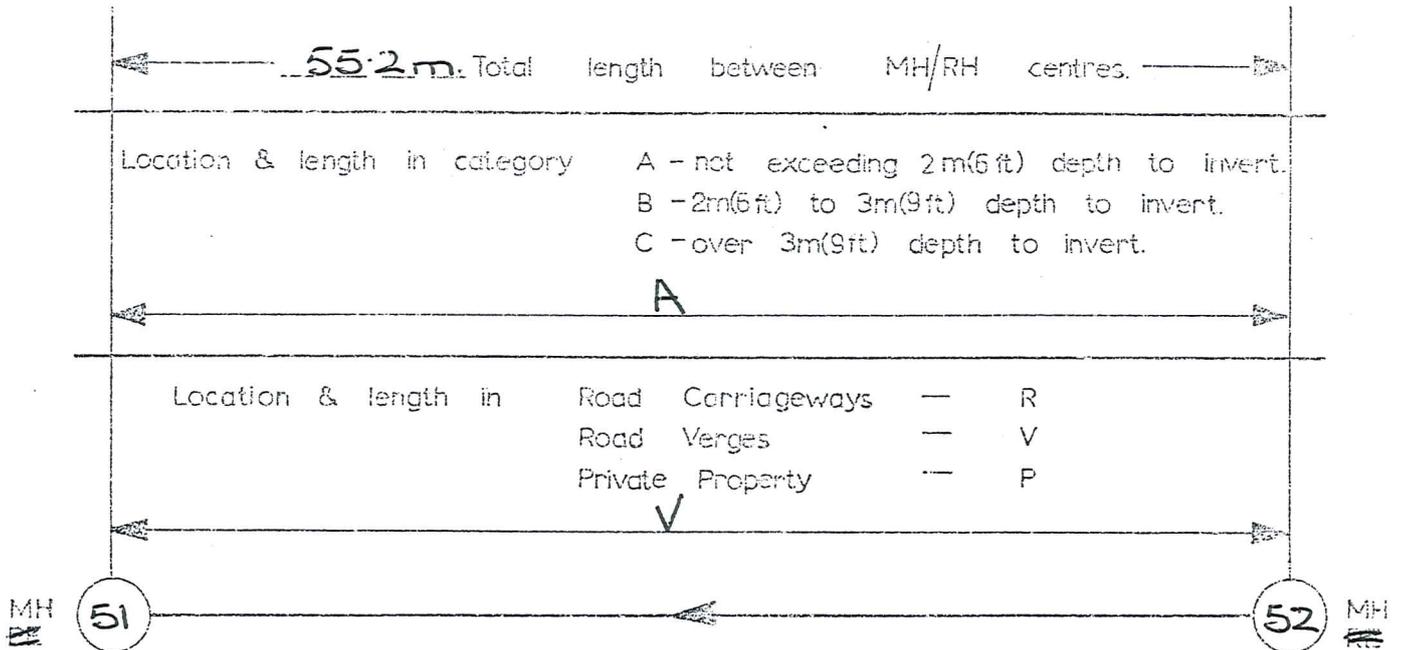

Distance	Service or Connection	Depth	Comments.
0	MH/≡ 51		
12.8	Connection		across Till st. (151 Scotland St)
28.2	"		153 Scotland St.
29.0	"		6 Till St.
48.5	"		across Till st. (No 7 Till St)
55.2	MH/≡ 52 (3 connections into Manhole.)		


Service or Connection — note saddles, Y junctions, other pipes, cables, etc.
 Also type and size.
 Depth — note depth to invert of pipes and services.
 Comments — note surface features and/or obstructions,
 also Rock (type, length, width, & depth excavated) and Haunching (type & length laid)

SEWER RECORD SHEET

SHEET NO 26
DATE 7-3-80

LOCAL AUTHORITY Roxburgh B.C. CONTRACT 3-Roxburgh Sewerage.
Drawing No 3060/20 Sewer Line JJ 150 dia. Class sewer Fibrelite pipes

AS BUILT AND EXISTING SERVICES DETAILS.

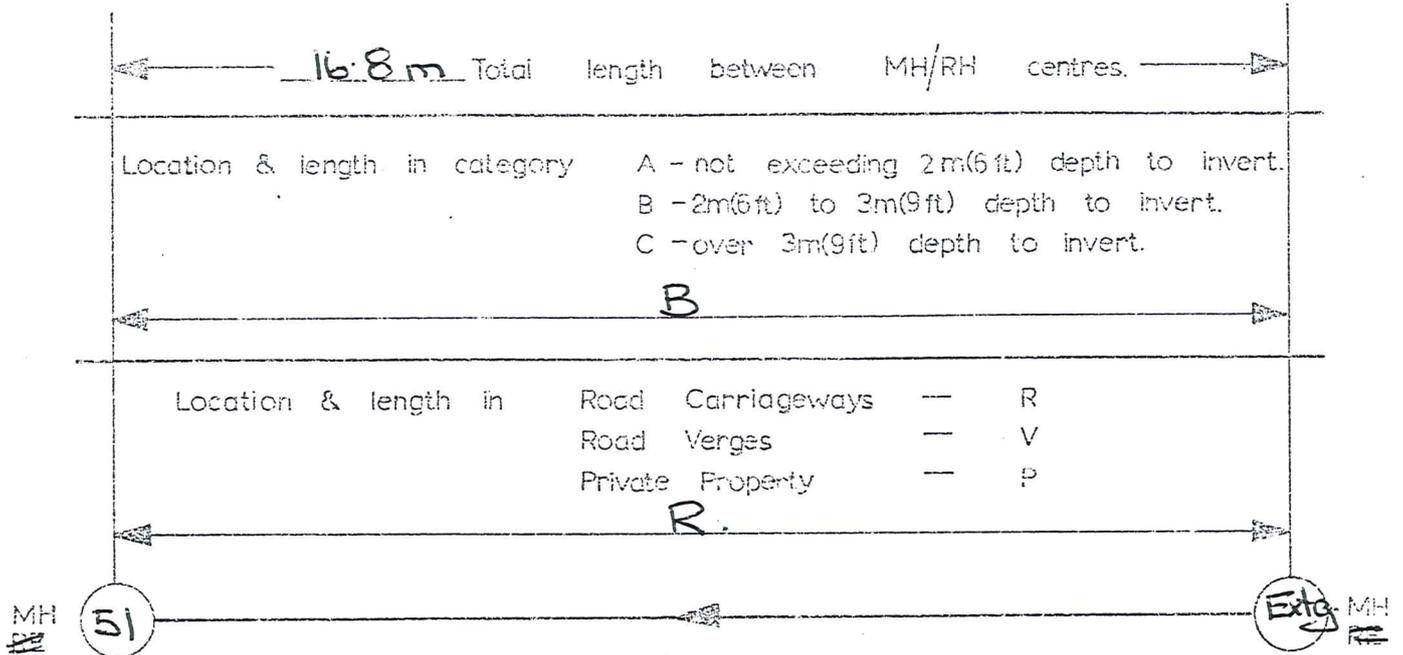

Distance	Service or Connection	Depth	Comments.
0	MH/RE <u>51</u>		
<u>16.8.</u>	MH/RE <u>Extg.</u>		

- Service or Connection — note saddles, Y junctions, other pipes, cables, etc. Also type and size.
- Depth — note depth to invert of pipes and services.
- Comments — note surface features and/or obstructions, also Rock (type, length, width, & depth excavated) and Haunching (type & length laid)


SEWER RECORD SHEET

SHEET NO. 27

DATE 7-3-80

LOCAL AUTHORITY Roxburgh B.C. CONTRACT 3 - Roxburgh Sewerage
 Drawing No. 3060/21 Sewer Line KK 225 dia. Class sewer Fibrolite pipes

AS BUILT AND EXISTING SERVICES DETAILS.

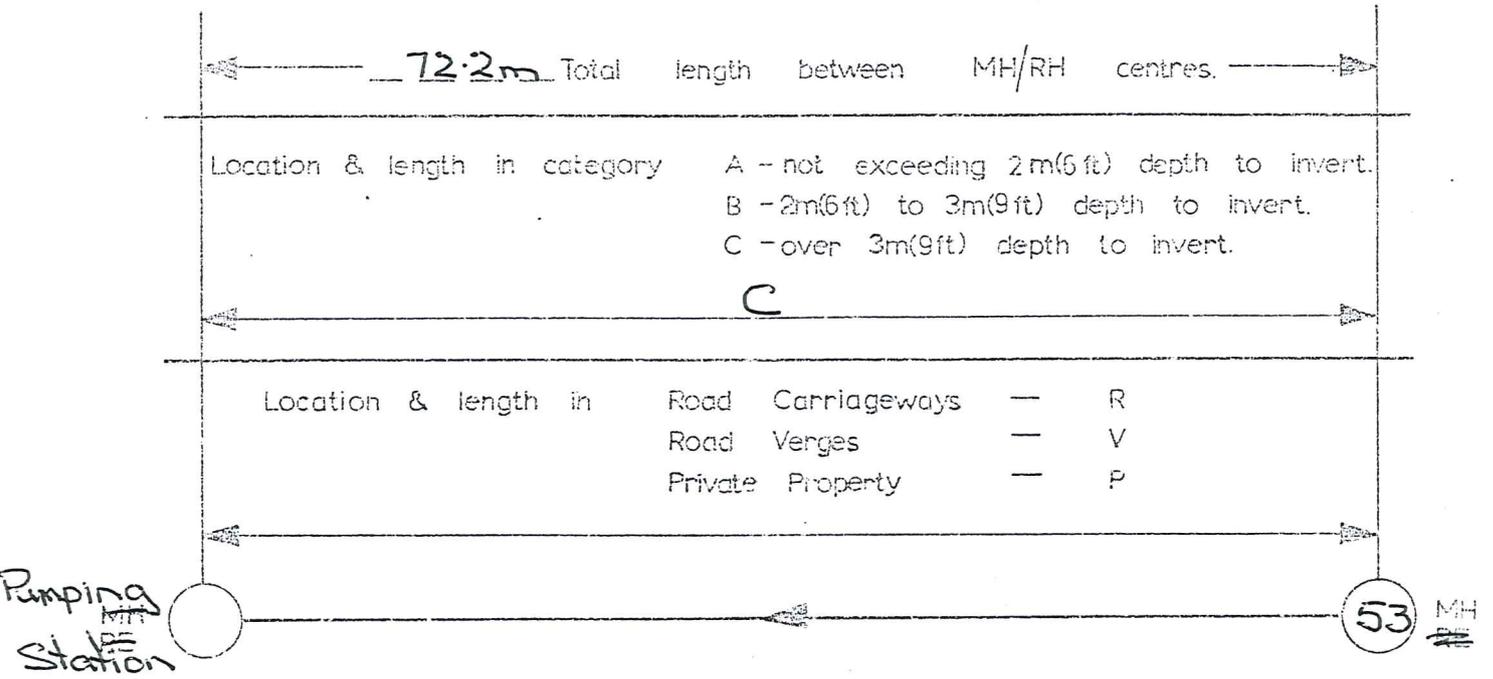

Distance	Service or Connection	Depth	Comments.
0	MH/SE Pumping Station No 3.		
72.2	MH/SE 53		

Service or Connection — note saddles, Y junctions, other pipes, cables, etc.
 Also type and size.

Depth — note depth to invert of pipes and services.


Comments — note surface features and/or obstructions, also Rock (type, length, width, & depth excavated) and Haunching (type & length laid)

SEWER RECORD SHEET

SHEET NO. 28
DATE 7-3-80

LOCAL AUTHORITY Roxburgh B.C. CONTRACT 3 - Roxburgh Sewerage
Drawing No. 3060/21 Sewer Line KK 225 dia. Class sewer fibrdite pipes

AS BUILT AND EXISTING SERVICES DETAILS.

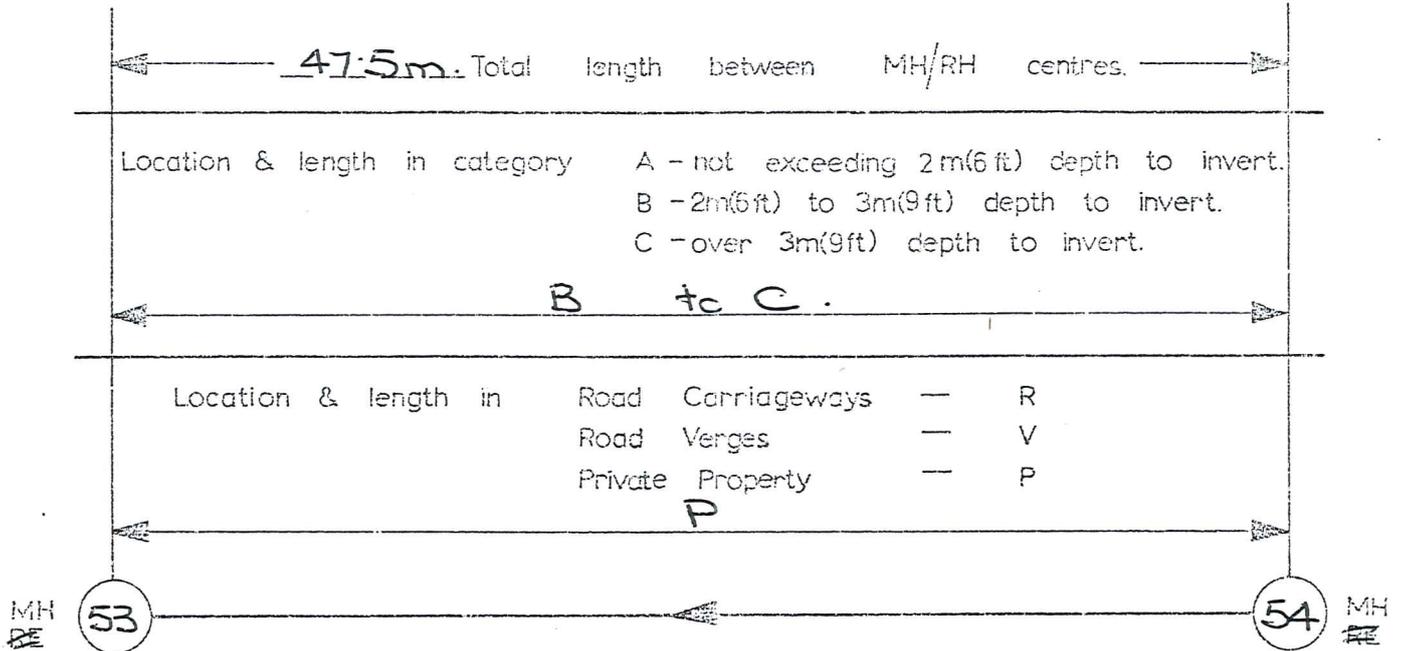

Distance	Service or Connection	Depth	Comments.
0	MH/RE 53		
47.5	MH/RE 54		

- Service or Connection — note saddles, Y junctions, other pipes, cables, etc. Also type and size.
- Depth — note depth to invert of pipes and services.
- Comments — note surface features and/or obstructions, also Rock (type, length, width, & depth excavated) and Haunching (type & length laid)


SEWER RECORD SHEET

SHEET NO. 29

DATE 10-3-80

LOCAL AUTHORITY Roxburgh B.C. CONTRACT 3-Roxburgh Sewerage
 Drawing No 3060/21 Sewer Line K-K 225 dia. Class Lower Fibrelite pipes

AS BUILT AND EXISTING SERVICES DETAILS.

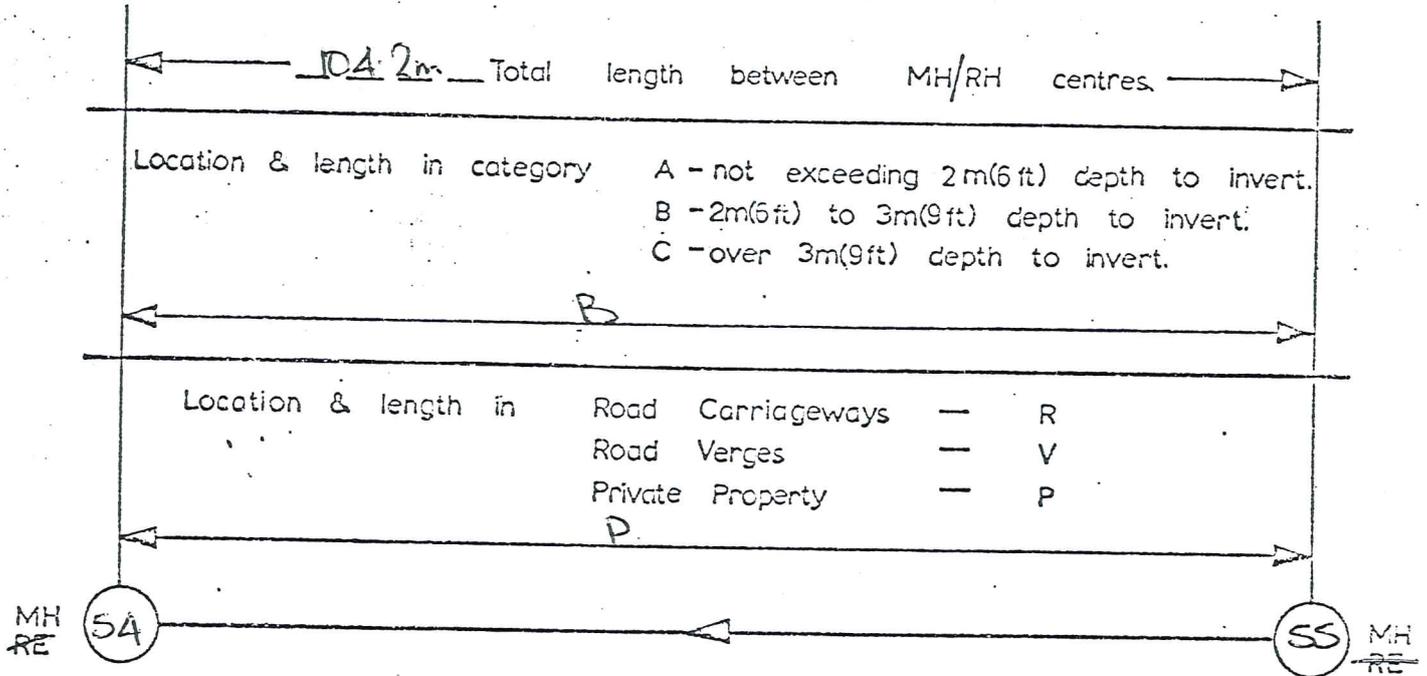

Distance	Service or Connection	Depth	Comments.
0	MH/RE 54		
16.7	Connection		No 171. Sealed St
17.7	"		Empty Section
30.4	"		Empty Section
31.4	"		No 173 Sealed St
50.7	"		No 175 "
51.7	"		Empty Section
78.3	"		Ops 177 & 179 Sealed St
79.5	100mm ϕ drain in Common		Ops 181 & 183 "
104.2m	MH/RE 55		

- Service or Connection — note saddles, Y junctions, other pipes, cables, etc.
 Also type and size.
- Depth — note depth to invert of pipes and services.
- Comments — note surface features and/or obstructions, also Rock (type, length, width, & depth excavated) and Haunching (type & length laid)


SEWER RECORD SHEET

SHEET NO. 30

DATE 7-3-80

LOCAL AUTHORITY Roxburgh B.C. CONTRACT 3 - Roxburgh Sewerage.
 Drawing No. 3060/21 Sewer Line KK 225 dia. Class sewer fibrelite pipes

AS BUILT AND EXISTING SERVICES DETAILS.

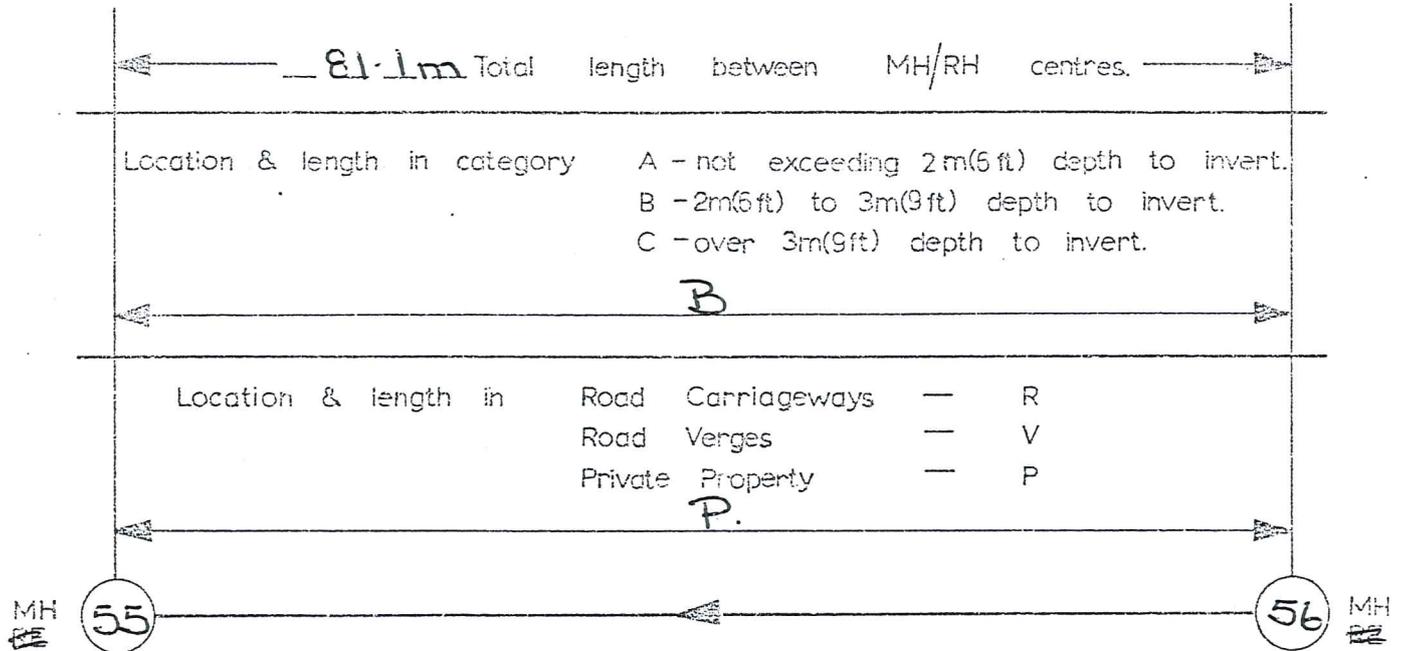

Distance	Service or Connection	Depth	Comments.
0	MH/55		
12.3	connection.		Nº 185 Scotland St
54.6	"		Nº 187. Scotland St
64.7	"		Teviol Transport. (first connection)
81.1	MH/56		Teviol Transport connection into M.H.

- Service or Connection — note saddles, Y junctions, other pipes, cables, etc.
Also type and size.
- Depth — note depth to invert of pipes and services.
- Comments — note surface features and/or obstructions,
also Rock (type, length, width, & depth excavated) and Haunching (type & length laid)


SEWER RECORD SHEET

SHEET NO. 31

DATE 7-3-80

LOCAL AUTHORITY Roxburgh B.C. CONTRACT 3 - Roxburgh Sewerage.
 Drawing No 3060/21 Sewer Line KK 150 dia. Class Sewer Fibrelite pipes

AS BUILT AND EXISTING SERVICES DETAILS.

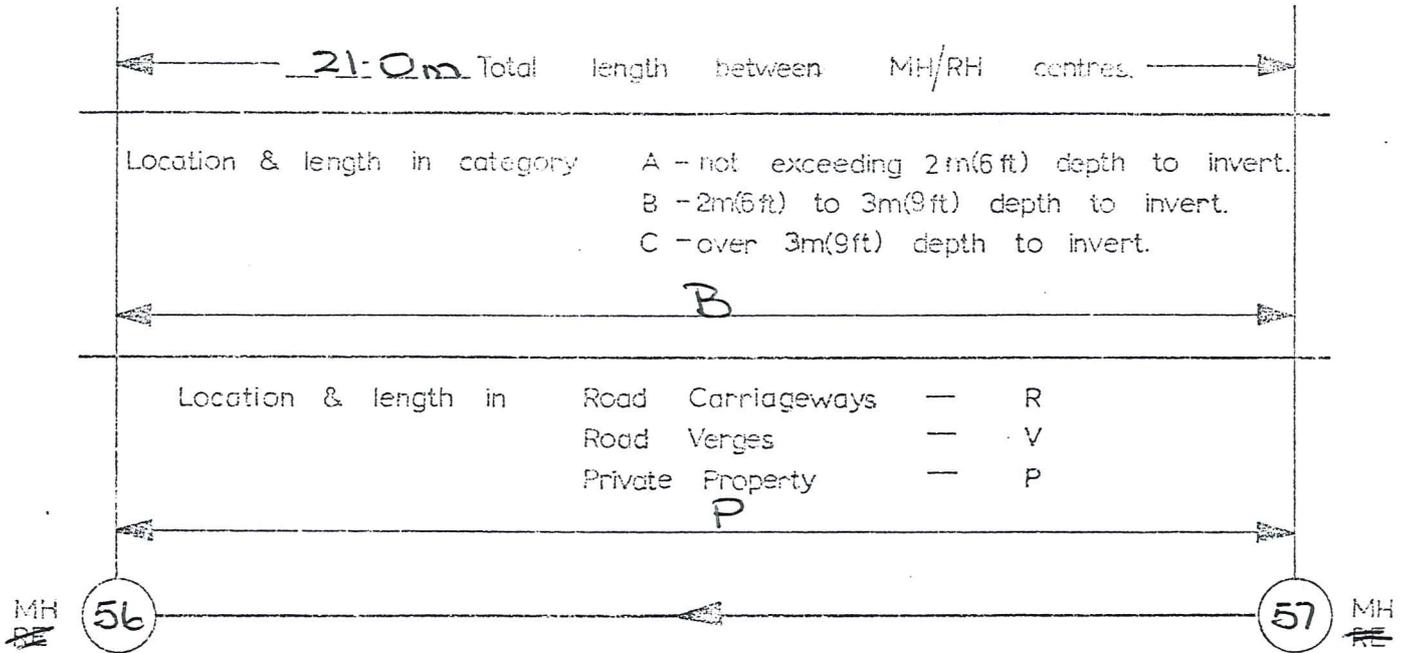

Distance	Service or Connection	Depth	Comments.
0	MH/ 56 <u>56</u> (Tewit Transport connection in MH)		
<u>21.0</u>	MH/ 57 <u>57</u>		

- Service or Connection — note saddles, Y junctions, other pipes, cables, etc. Also type and size.
- Depth — note depth to invert of pipes and services.
- Comments — note surface features and/or obstructions, also Rock (type, length, width, & depth excavated) and Haunching (type & length laid)


SEWER RECORD SHEET

SHEET NO. 32

DATE 7-3-80

LOCAL AUTHORITY Roxburgh B.C. CONTRACT 3 - Roxburgh Sewerage
 Drawing No. 3060/21 Sewer Line KIK 150 dia. Class sewer fibrolite pipes

AS BUILT AND EXISTING SERVICES DETAILS.

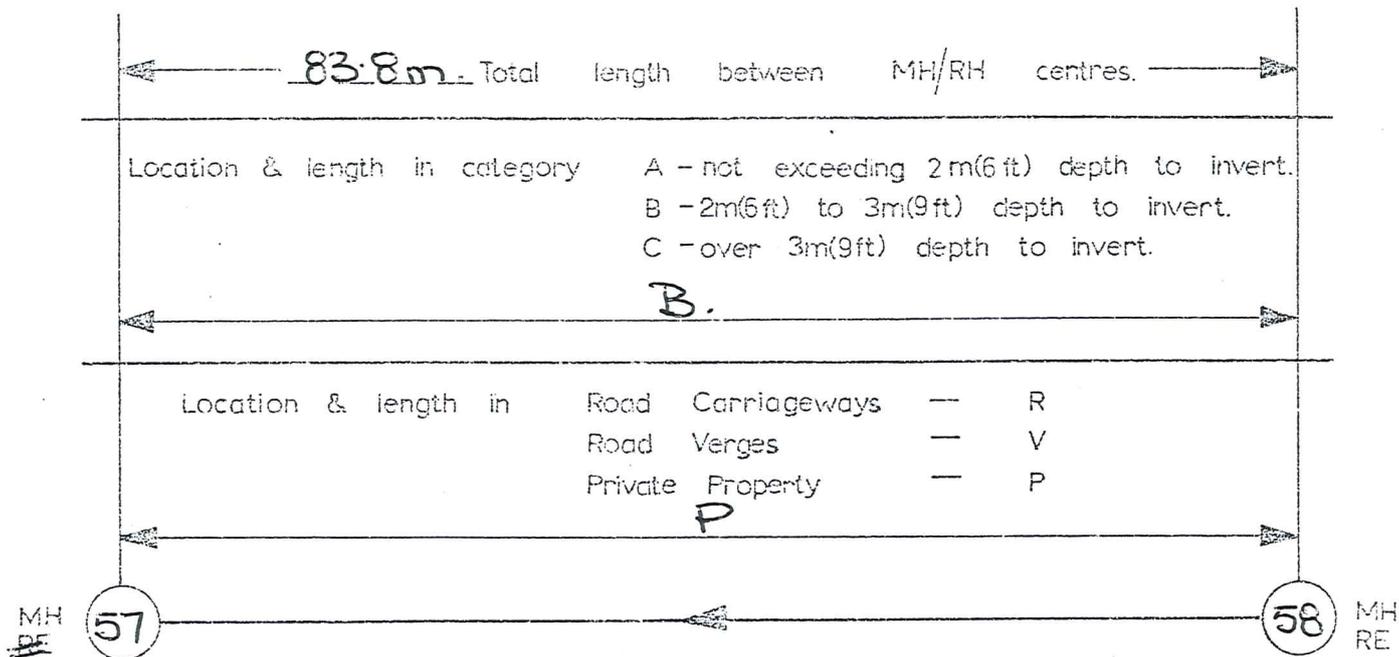

Distance	Service or Connection	Depth	Comments.
0	MH/RE 57		
	Connection into MH		10° 193A
83.8	MH/RE 58		

- Service or Connection — note saddles, Y junctions, other pipes, cables, etc. Also type and size.
- Depth — note depth to invert of pipes and services.
- Comments — note surface features and/or obstructions, also Rock (type, length, width, & depth excavated) and Haunching (type & length laid)


SEWER RECORD SHEET

SHEET NO. 33

DATE 7-3-80

LOCAL AUTHORITY Roxburgh B.C. CONTRACT 3 - Roxburgh Sewerage.
 Drawing No. 3060/21 Sewer Line K.K. 150 dia. Class sewer Fibrolite pipes

AS BUILT AND EXISTING SERVICES DETAILS.

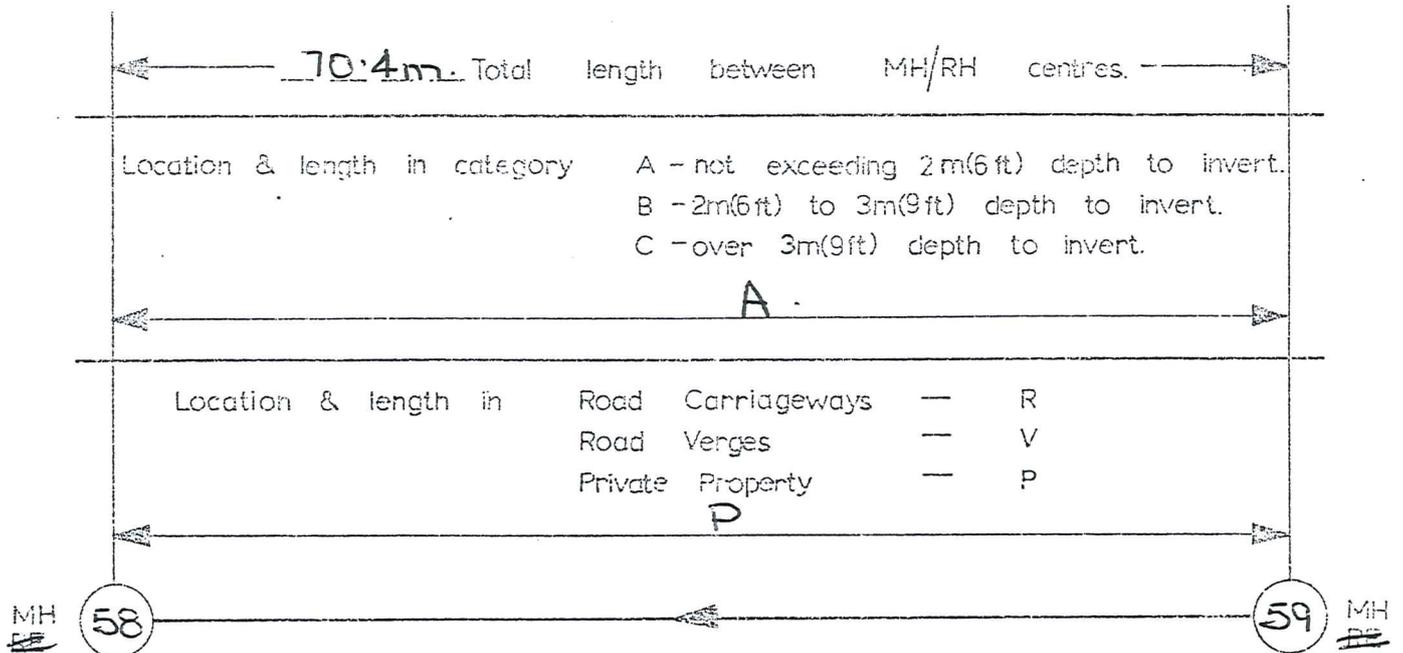

Distance	Service or Connection	Depth	Comments.
0	MH/ 58 58		
20.4m	Connection		100mmφ N° 203 Scotland St
23.9m	Connection		100mmφ N° 205 " "
49.1m	Connection		100mmφ N° 207 " "
65.5m	Connection		100mmφ N° 209 " "
70.4m	MH/ 58 59		

Service or Connection — note saddles, Y junctions, other pipes, cables, etc.
 Also type and size.

Depth — note depth to invert of pipes and services.

Comments — note surface features and/or obstructions,
 also Rock (type, length, width, & depth excavated) and Haunching (type & length laid)


SEWER RECORD SHEET

SHEET NO. 34

DATE 7-3-80

LOCAL AUTHORITY Roxburgh B.C. CONTRACT 3 - Roxburgh Sewerage
 Drawing No. 3060/21 Sewer Line KK 150 dia. Class sewer Fibrelite pipes

AS BUILT AND EXISTING SERVICES DETAILS.

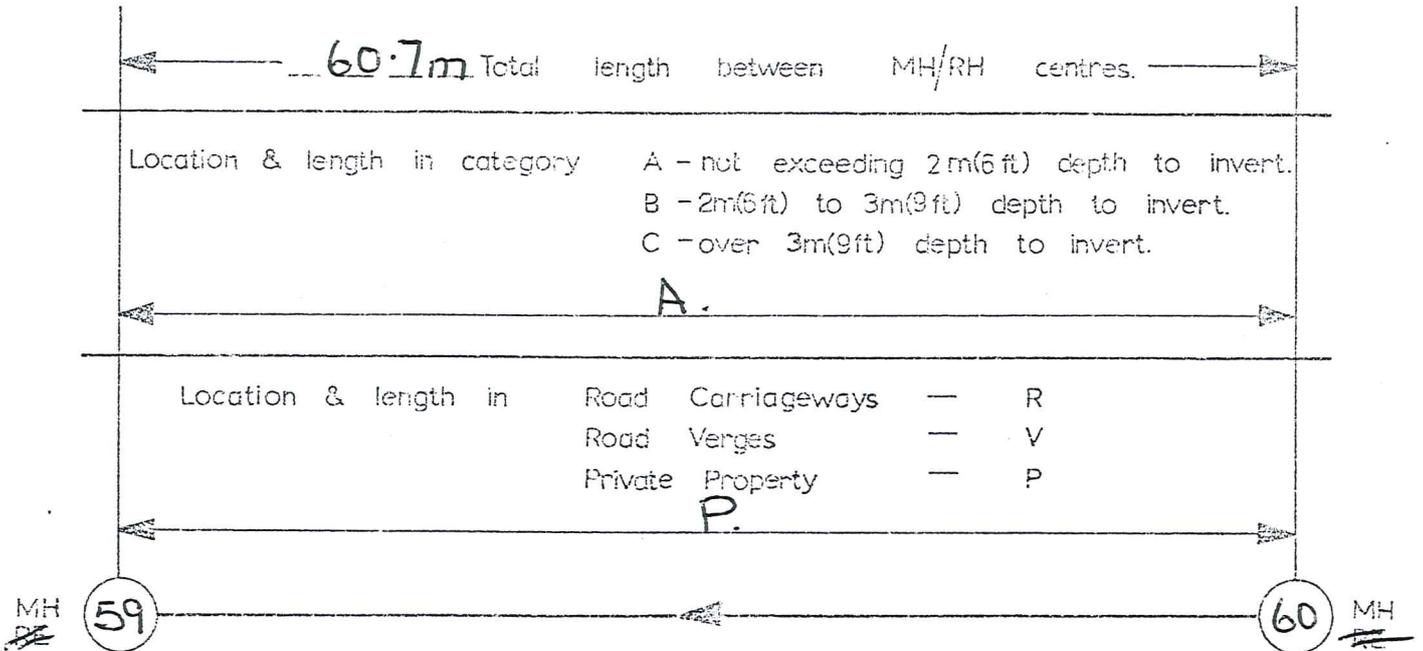

Distance	Service or Connection	Depth	Comments
0	MH/59		
20.8m	Connection		100mm ϕ No 211 Section 81
37.6m	Connection		100mm ϕ No 213 " "
54.0m	Connection		100mm ϕ No 215 " "
	Connection into Manhole		No 217 " "
60.7m	MH/60		


- Service or Connection — note saddles, Y junctions, other pipes, cables, etc. Also type and size.
- Depth — note depth to invert of pipes and services.
- Comments — note surface features and/or obstructions, also Rock (type, length, width, & depth excavated) and Haunching (type & length laid)

SEWER RECORD SHEET

SHEET NO. 35
DATE 7-3-80

LOCAL AUTHORITY Roxburgh B.C. CONTRACT 3 - Roxburgh Sewerage.
Drawing No. 3060/18 Sewer Line LL 150 dia. Class sewer Fibrolite pipes

AS BUILT AND EXISTING SERVICES DETAILS.

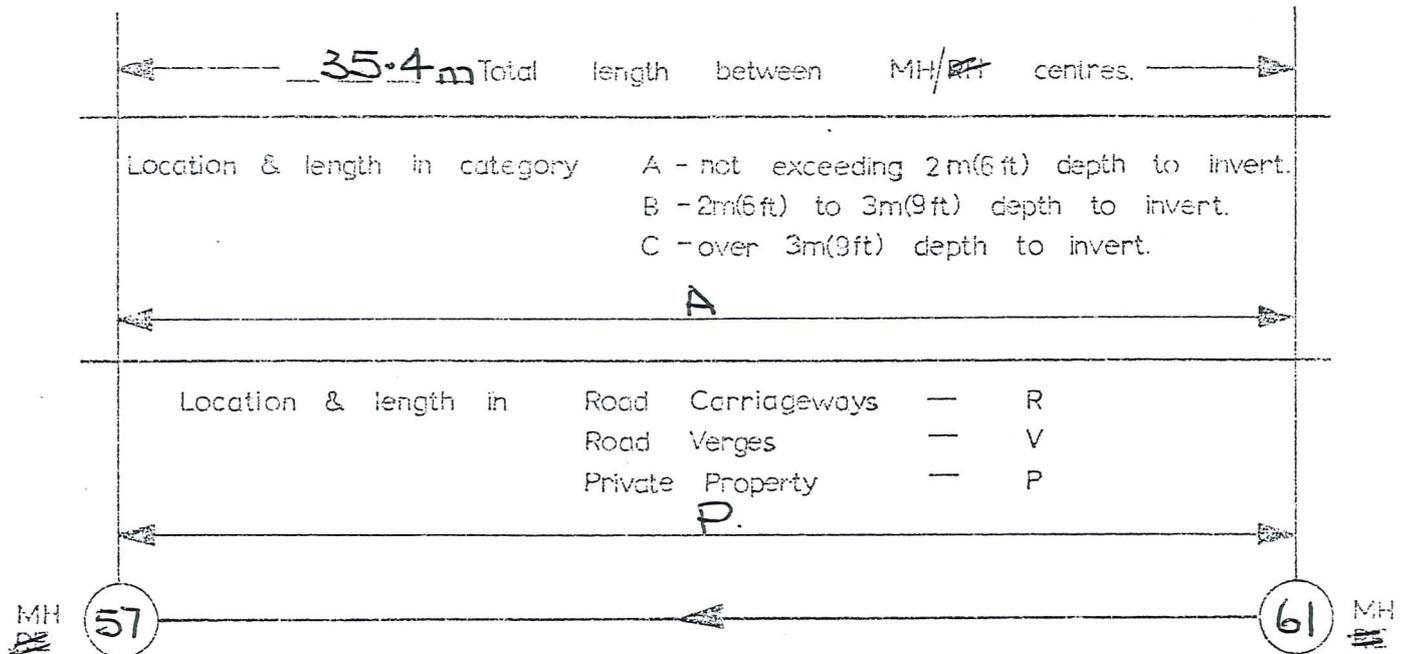

Distance	Service or Connection	Depth	Comments.
0	MH/PP <u>57</u>		
<u>35.4</u>	MH/PP <u>61</u>		

Service or Connection — note saddles, Y junctions, other pipes, cables, etc.
Also type and size.

Depth — note depth to invert of pipes and services.

Comments — note surface features and/or obstructions, also Rock (type, length, width, & depth excavated) and Haunching (type & length laid)


SEWER RECORD SHEET

SHEET NO. 36

DATE 7-3-80

LOCAL AUTHORITY Roxburgh B.C. CONTRACT 3 - Roxburgh Sewerage
 Drawing No. 3060/18 Sewer Line LL 150 dia. Class sewer fibrolite pipes

AS BUILT AND EXISTING SERVICES DETAILS.

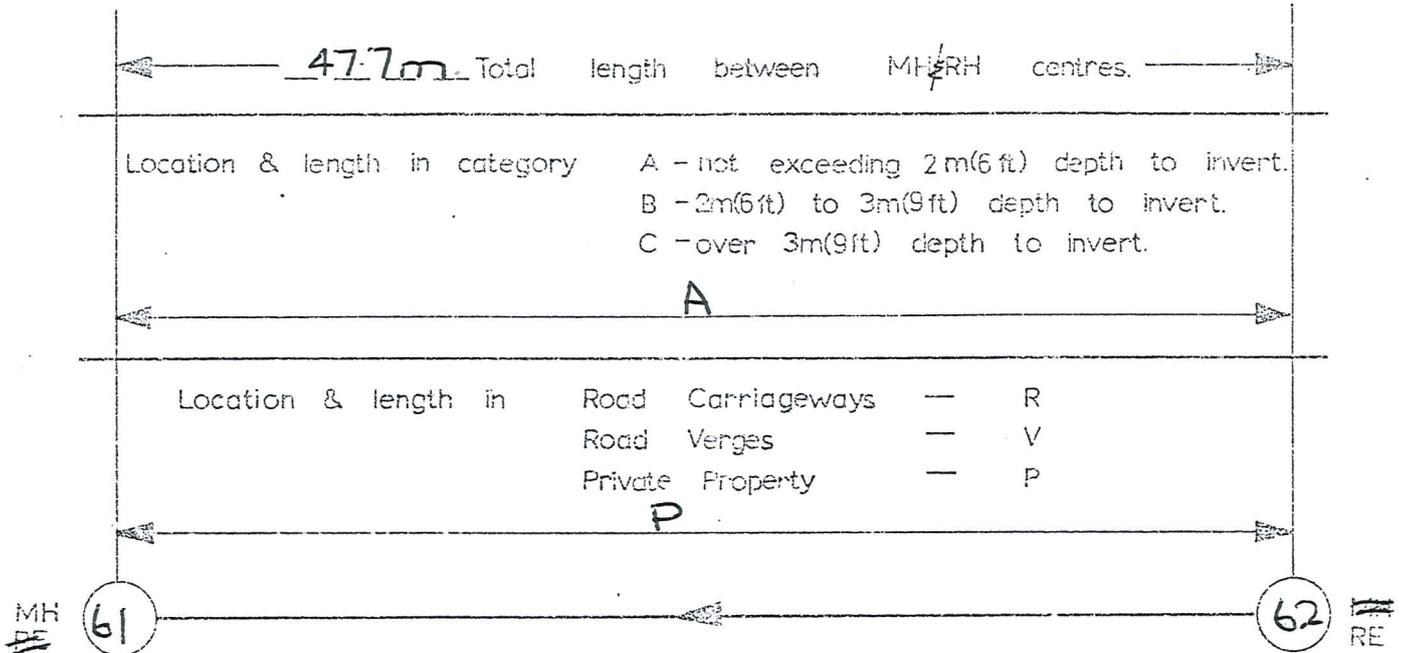

Distance	Service or Connection	Depth	Comments.
0	MH/RE 61		
0.	Connection		Into Manhole Ref Drawing (No 191)
15m	Connection		Inspection at Connection (No 193)
21m	Connection		Inspection 0.8 from line (No 195)
34m	Connection		Inspection 4.1m from line (No 197)
47m	Connection		Inspection 1.9 m from line (No 199)
			(All houses are in Scotland St)
47.7	RE 62		


- Service or Connection — note saddles, Y junctions, other pipes, cables, etc. Also type and size.
- Depth — note depth to invert of pipes and services.
- Comments — note surface features and/or obstructions, also Rock (type, length, width, & depth excavated) and Haunching (type & length laid)

SEWER RECORD SHEET

SHEET NO. 37
DATE 7-3-80

LOCAL AUTHORITY Roxburgh B.C. CONTRACT 3 - Roxburgh Sewerage.
Drawing No. 3060/18 Sewer Line M.M. 150 dia. Class sewer Fibrolite pipes

AS BUILT AND EXISTING SERVICES DETAILS.

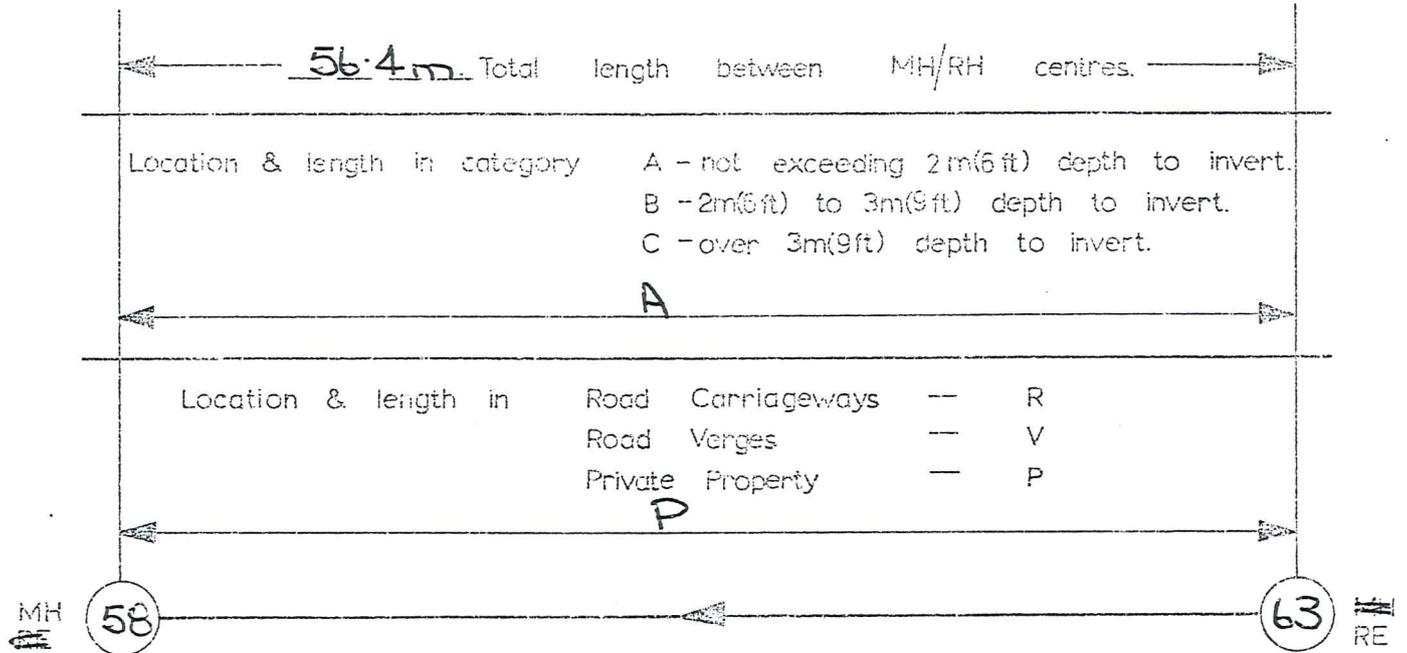


Distance	Service or Connection	Depth	Comments.
0	MH/RE <u>58</u>		
<u>14.8m</u>	<u>Connection.</u>		<u>Nº 201A Scotland St</u>
<u>54.9m</u>	<u>Connection.</u>		<u>Nº 201 Scotland St</u>
<u>56.4</u>	MH/RE <u>63.</u>		

Service or Connection — note saddles, Y junctions, other pipes, cables, etc.
Also type and size.

Depth — note depth to invert of pipes and services.

Comments — note surface features and/or obstructions, also Rock (type, length, width, & depth excavated) and Haunching (type & length laid)

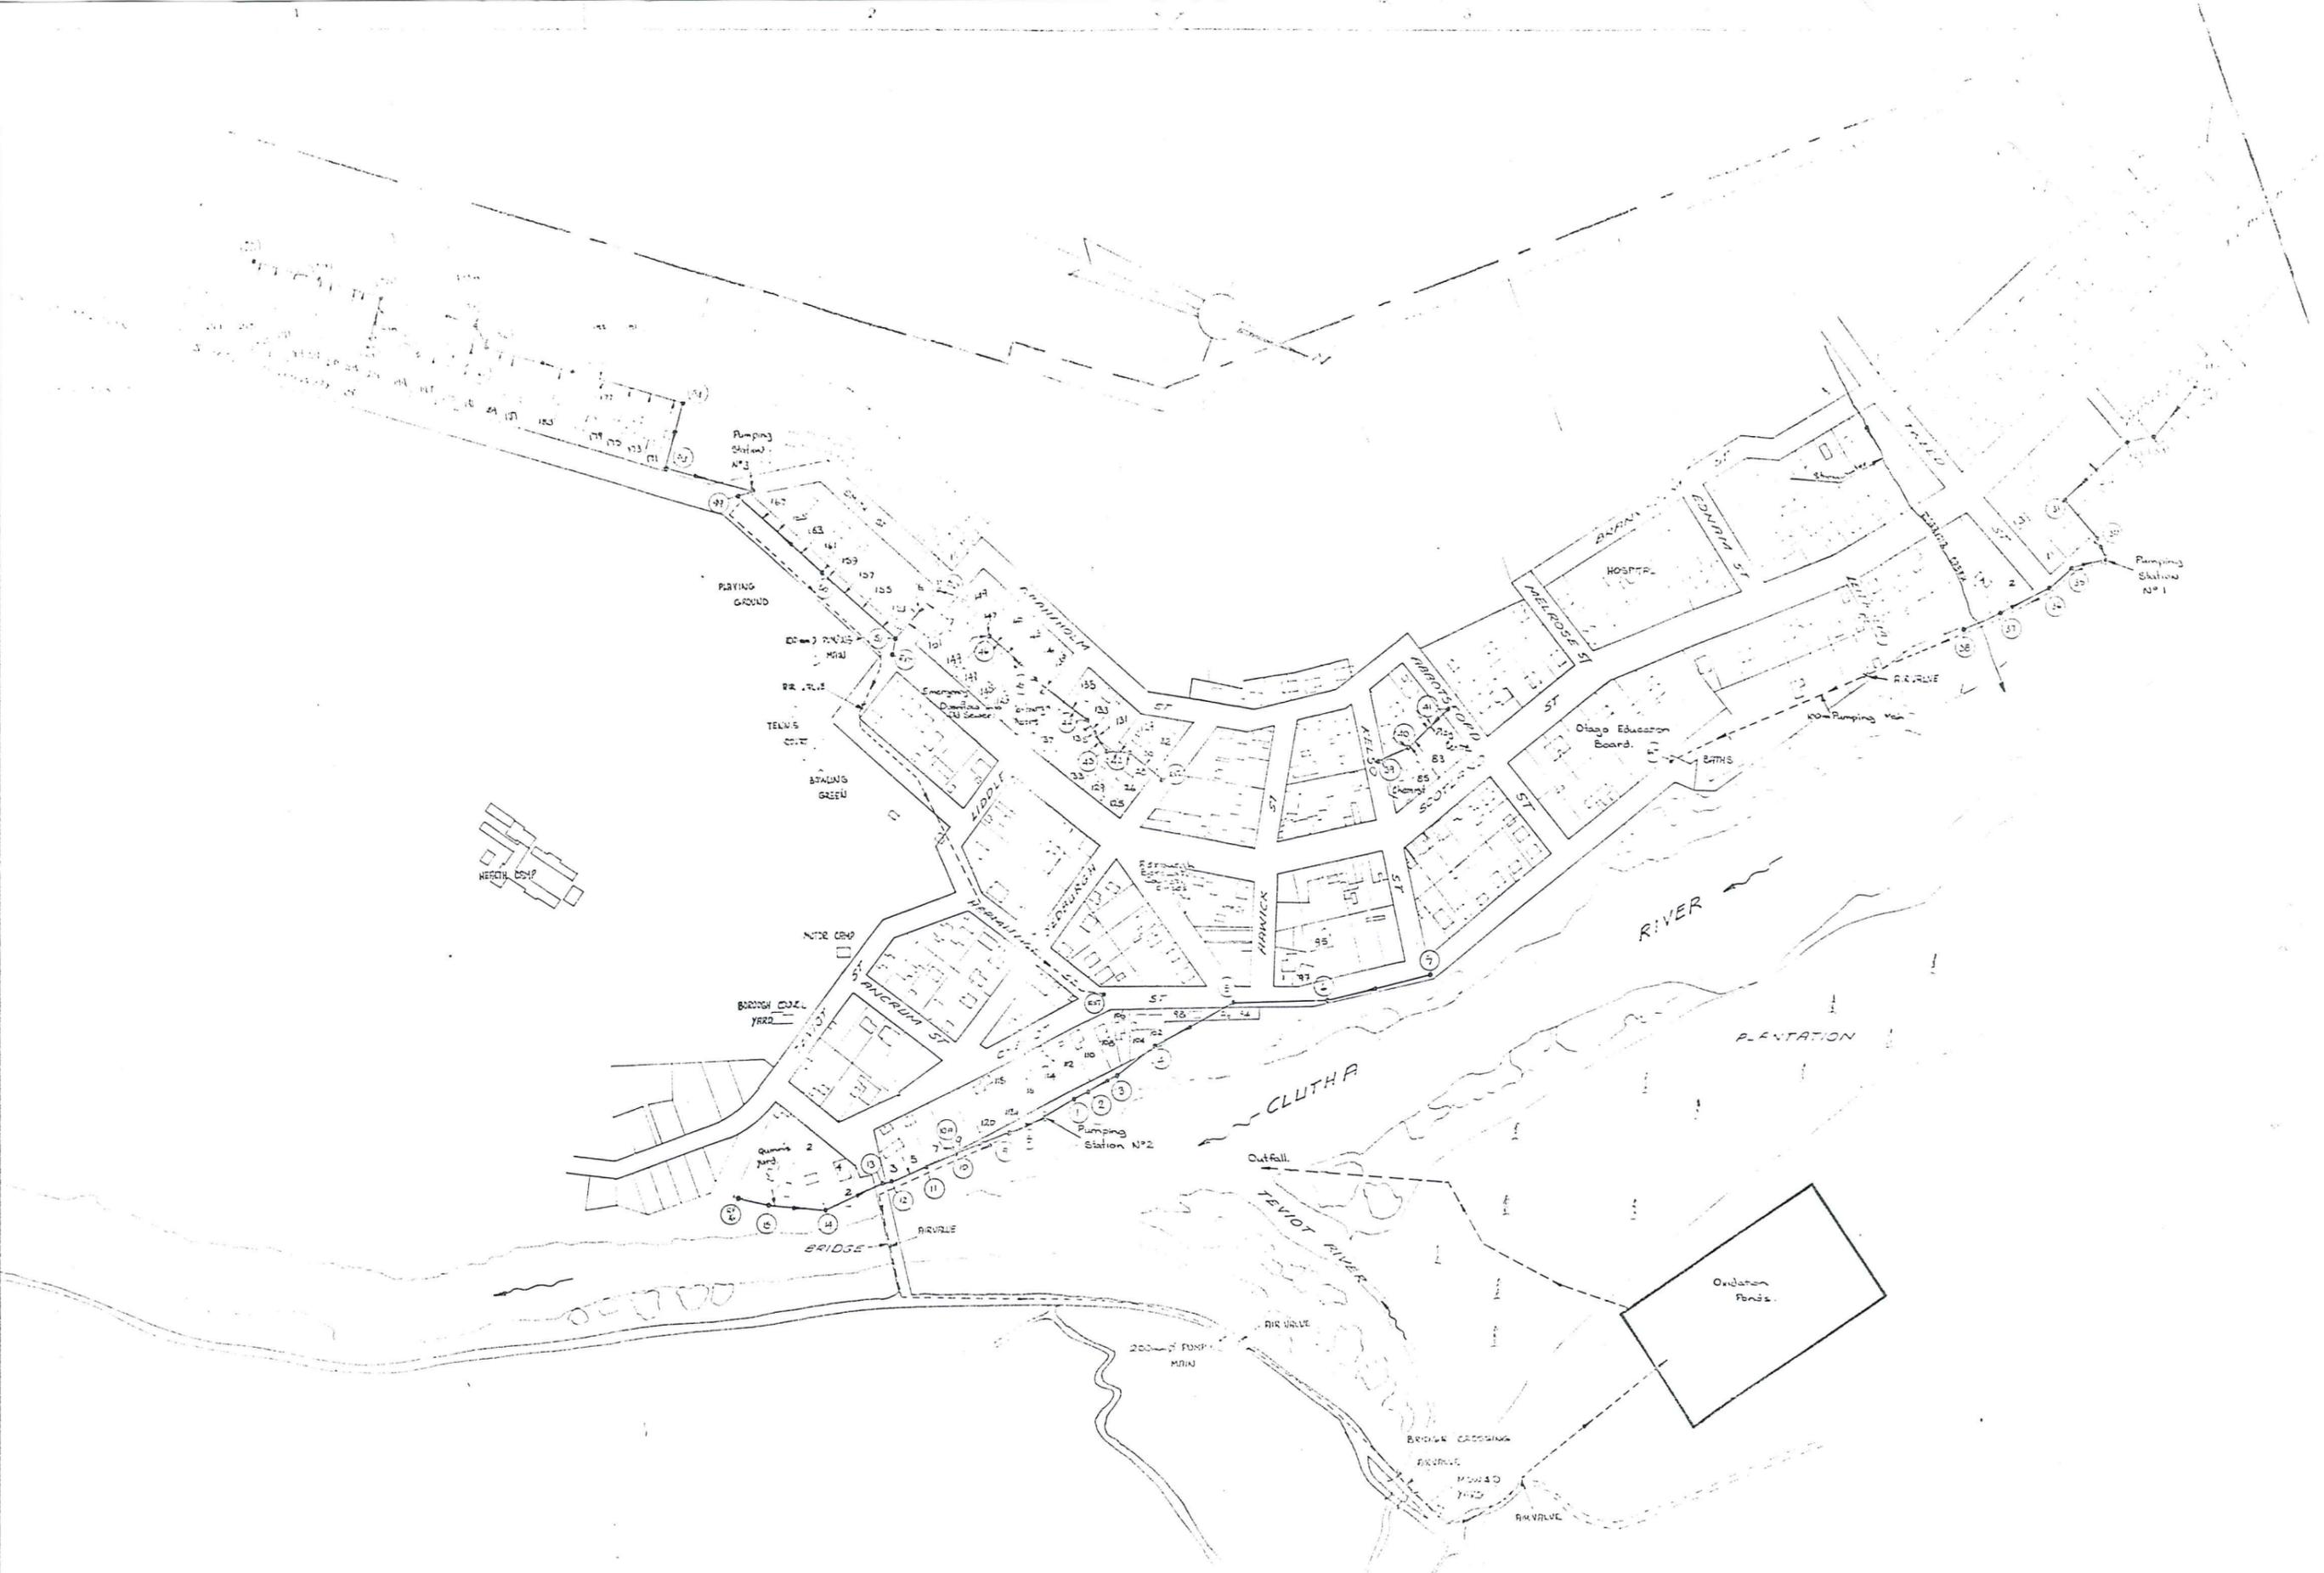

W. B. GARDNER & PARTNERS ENGINEERS & ARCHITECTS 100, RIVER STREET DUNEDIN	FOXBURGH BOROUGH COUNCIL JULY 27 1922 J.W.G.	FOXBURGH SEWERAGE - AS PER THE LAYOUT OF SEWERAGE LAID IN ALL CONTRACTS	3387/1
--	--	---	--------