


15/4/20/5/1

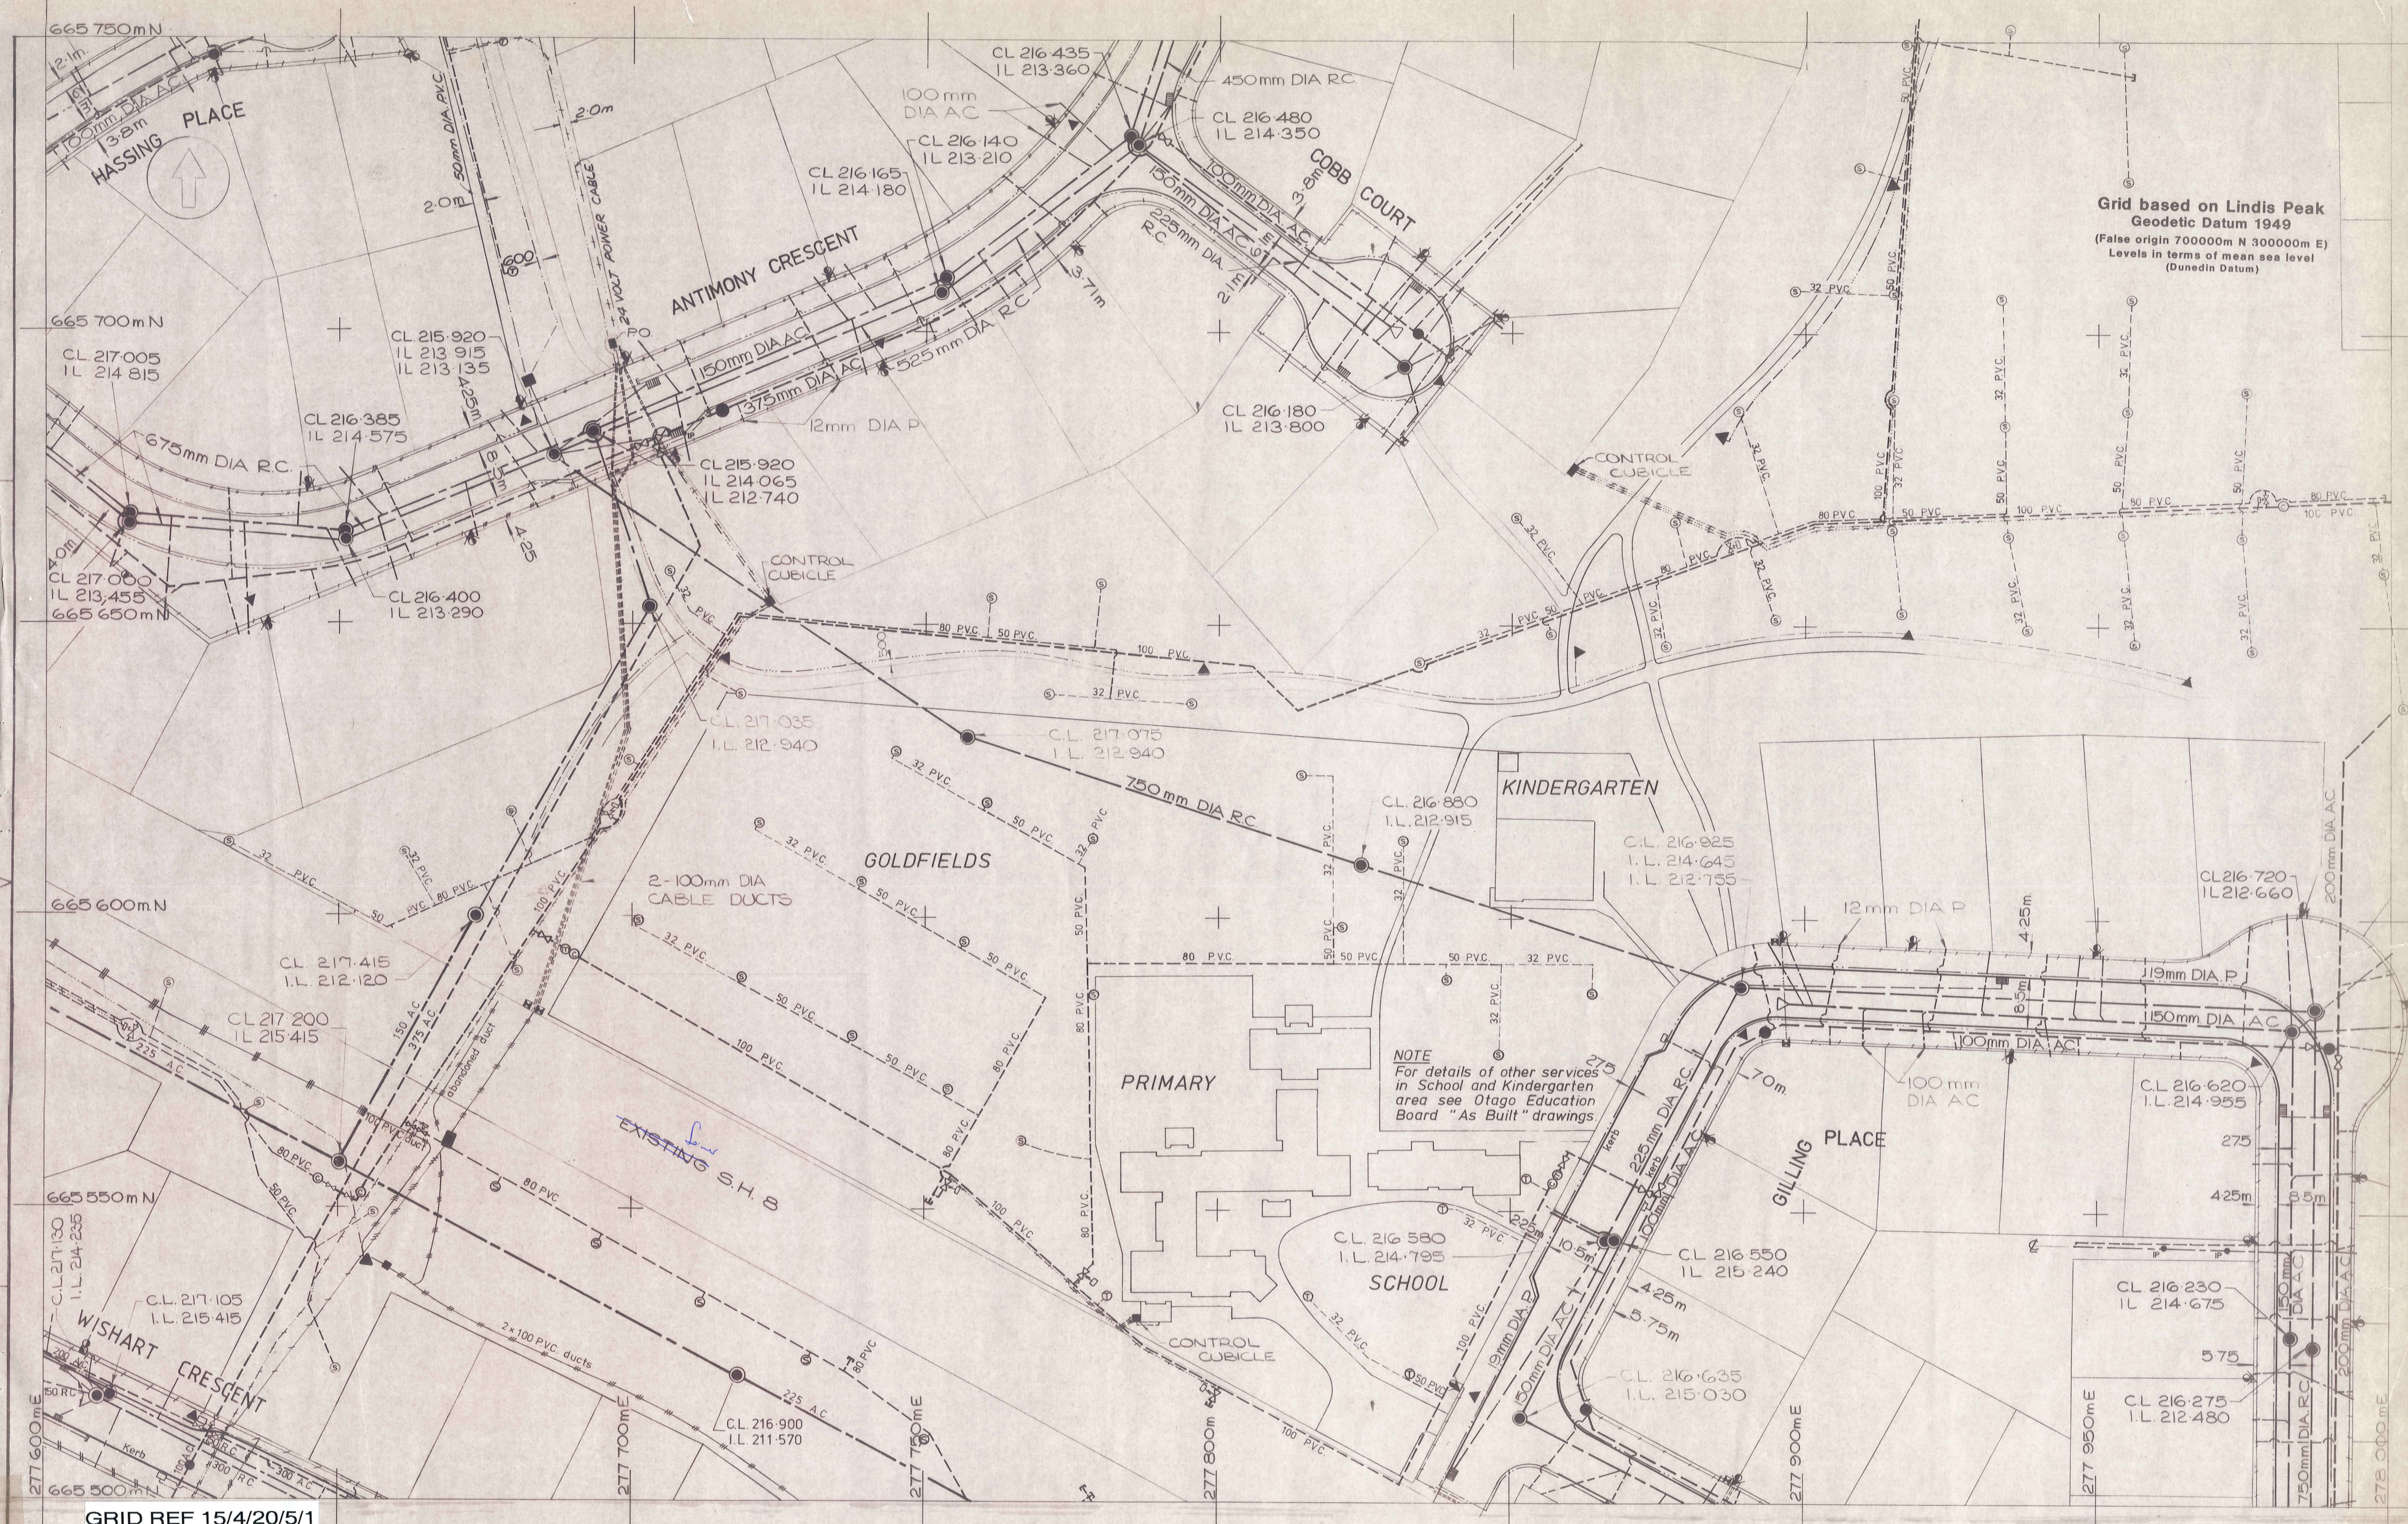

Grid based on Lindis Peak
Geodetic Datum 1949
(False origin 700000m N 300000m E)
Levels in terms of mean sea level
(Dunedin Datum)

NOTE
For details of other services
in School and Kindergarten
area see Otago Education
Board "As Built" drawings

GRID REF 15/4/20/5/1

SERVICES RECORD DRAWINGS OF CROMWELL

| | | |
|--|---------------------|---------------------|
| PREPARED BY: DUFFILL WATTS & KING LTD. CONSULTING CIVIL & STRUCTURAL ENGINEERS DUNEDIN, INVERCARGILL, BALCLUTHA, CROMWELL | DATE: MARCH 1981 | 20/5 PRELIMINARY |
| | SCALE: 1:500 | |